

M^cPherson

FORM 252A (5M-8-30-PETROL)

Map No. KANSAS Sec. 11 Twp. 19 R. 2^w

Well No. 3 - Fleming Farm
M^cPherson & Shell Company


660 Ft. from N. Line

_____ Ft. from S. Line

660 Ft. from E. Line

_____ Ft. from W. Line

1931

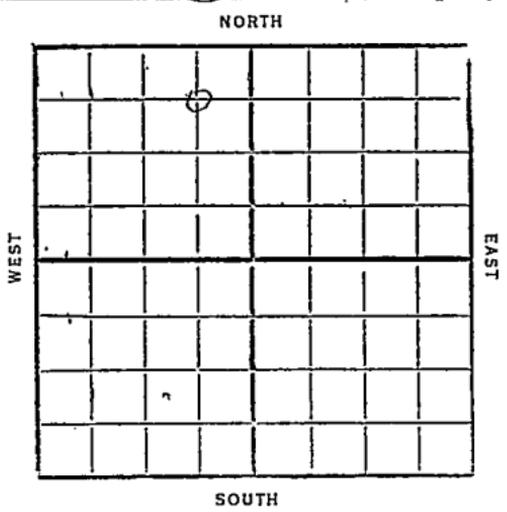

Date	REPORT
7/22	Cellar
7/29	—
8/5	—
8/12	—
8/19	—
8/26	—
9/2	—
9/9	—
9/16	—
9/23	—
9/30	—
10/7	—
10/14	—
10/21	—
10/28	—
11/4	—
11/10	—
11/18	Cellar
11/24	— 12/22 — 1/13 —
12/2	— 12/30 — 1/20 —
12/9	— 1932 1/27 —
12/16	— 1/6 — 2/3 —

2/10- Cellar

2/17 —

2/26- Abandon loc

McPherson

Map No. **KANSAS** Sec. *11* Twp. *19* R. *2* W.

Well No. *43 3 Fleming*

McPherson & Sheel Company
Contractor

FIRST REPORTS

660 Ft. from N. Line
..... Ft. from S. Line
660 Ft. from E. Line
..... Ft. from W. Line

SECTION PLAT

	0		

Location.....
Rig up *Collar*
Drilling and Remarks:

RECORD

Cased..... in., ft.
Sand.....
Gas.....
Oil.....
Total Depth.....

PRODUCTION

1st 24 hrs. Nat.....
1st 24 hrs. after shot.....
Gas..... Cu. Ft.
Dry Hole.....
Abandoned.....

Date
JUL 22 1931

CHAS. L. SHERWOOD

W. C. C. P.

James J.

Returned	
Cards	<i>JS</i>
Tracing	<i>JS</i>
France Map	<i>JS</i>
Scarborough Map	<i>JS</i>
Moody Map	<i>JS</i>
Scarborough Plat Book	<i>JS</i>
Moody Plat Book	

McPherson

43

KANSAS

Map No.

Sec. *11*

Twp. *19*

R. *2*^W

Well No. *3 Fleming*

McPherson & Shell

Company

Contractor

COMPLETE

660 Ft. from N. Line

_____ Ft. from S. Line

660 Ft. from E. Line

_____ Ft. from W. Line

ABANDONED

SECTION PLAT

	<i>0</i>		

Location _____

Rig up _____

Drilling and Remarks:

RECORD

Cased _____ in., _____ ft.

Sand _____

Gas _____

Oil _____

Total Depth _____

PRODUCTION

1st 24 hrs. Nat. _____

1st 24 hrs. after shot _____

Gas _____ Cu. Ft.

Dry Hole _____

Abandoned *location*

Date

FEB 26 1932

CHAS. L. SHERWOOD

Scout

was used

Returned	<i>FB</i>
Cards	
Tracing	<i>OK</i>
France Map	<i>X</i>
Scarborough Map	<i>X</i>
Moody Map	<i>X</i>
Scarborough Plat Book	
Moody Plat Book	