


Form 51-5M-2-29-34703

Map No. KANSAS Sec. 5 Twp. 19 R. d

Well No. 5 Springs Farm

M^cThurson & Shell Company

NORTH

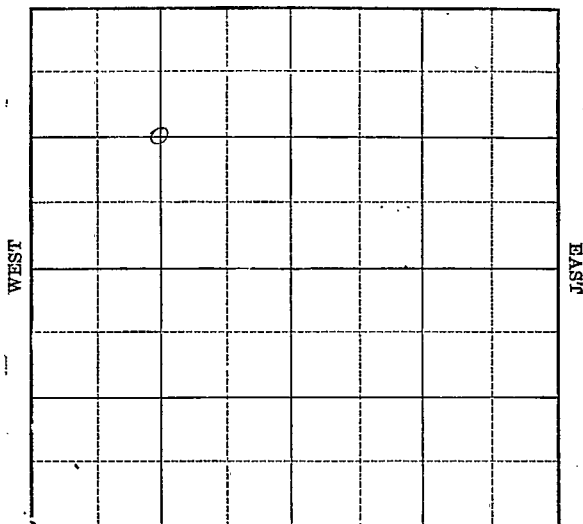

SOUTH

Location_____

Drilling Remarks

Rig Up

Drilling Remarks

RECORD

Cased_____in._____ft.

Sand

Gas

Oil

Total Depth.....

PRODUCTION

1st 24 hrs. Nat.-----

1st 24 hrs. after shot.-----

Gas _____ cu. ft. _____

Dry Hole

Abandoned_____

Map No. KANSAS Sec. 11 Twp. 19 R. 2^w

Well No. 1 - Fleming Farm

M. C. Pherson Oil & Land Shull Company


1312 Ft. from N. Line

_____ Ft. from S. Line

_____ Ft. from E. Line

1326 Ft. from W. Line

1913

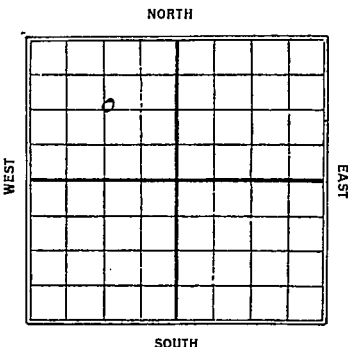

Date

REPORT

8/6	Loc
8/13	
8/20	Spud
8/27	blblg. 680'
9/3	" 1235'
9/10	12" - 1450
9/17	drlg 1830'
9/24	" 2195'
9/24	" 2375'
10/1	U/R 8" - 2660'
10/8	Top Chat 2907
	Cementing 8"
10/15	Pulling big pipe
10/22	Chat 2907-23
	T.D. 2923
	14 # gas
	945 # R.P.
	Comp.

W. P. Pearson
 Map No. **KANSAS** Sec. 11 Twp. 19 R. 2W
 Well No. 43 1 Fleming

W. P. Pearson Oil & Shell Company

Contractor

SECTION PLAT

1812 Ft. from N. Line

_____ Ft. from S. Line

_____ Ft. from E. Line

1826 Ft. from W. Line

FIRST REPORTS

Location ✓

Rig up _____

Drilling and Remarks:

RECORD

Cased _____ in., _____ ft.

Sand _____

Gas _____

Oil _____

Total Depth _____

PRODUCTION

1st 24 hrs. Nat. _____

1st 24 hrs. after shot _____

Gas _____ Cu. Ft.

Dry Hole _____

Abandoned _____

Date

AUG 6 1930

S. J. LEWIS

Scout

Map No. KANSAS Sec. 11 Twp. 19 R. 2 WWell No. 43 1 FlemingW. P. P. & G. & C. Shell Company

Contractor

SECTION PLAT

1812 Ft. from N. Line

Ft. from S. Line

Ft. from E. Line

1826 Ft. from W. Line

COMPLETED

Location

Rig up

Drilling and Remarks:

940# R. P.

RECORD

Cased _____ in., _____ ft.

Said 2907-23Gas 14 M

Oil _____

Total Depth 2923

PRODUCTION

1st 24 hrs. Nat. _____

1st 24 hrs. after shot _____

Gas _____ Cu. Ft.

Dry Hole _____

Abandoned _____

Date

OCT 22 1930

192

S. J. LEWIS Scout