

McPherson


Form 51-5M-5-34-Palace

Map No. KANSAS Sec. 11 Twp. 19 R. 2W

Well No. B Decker Farm

Shell Pet. Company

NORTH

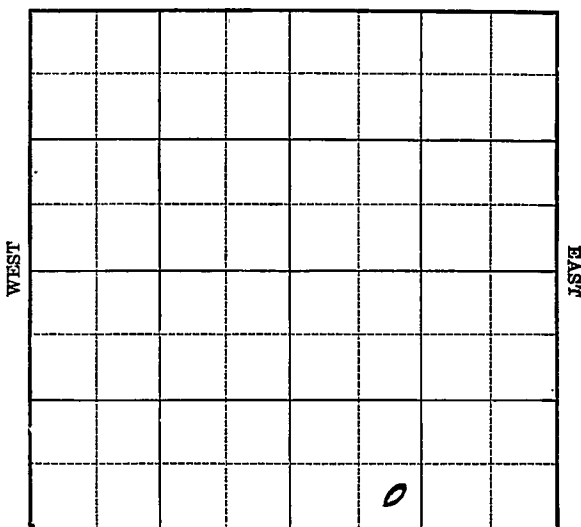

SOUTH

O. W. D. D

Location _____

Drilling Remarks _____

Rig Up _____

Drilling Remarks _____

RECORD

Cased _____ in. _____ ft.

Sand _____

Gas _____

Oil _____

Total Depth _____

PRODUCTION

1st 24 hrs. Nat. _____

1st 24 hrs. after shot _____

Gas _____ cu. ft.

Dry Hole _____

Abandoned _____

McPherson

Map No. KANSAS Sec. 11 Twp. 19 R. 2W


Well No. 8 Decker Farm
Shell Pet. Company

 Ft. from N. Line

330 Ft. from S. Line

 Ft. from E. Line

1025 Ft. from W. Line

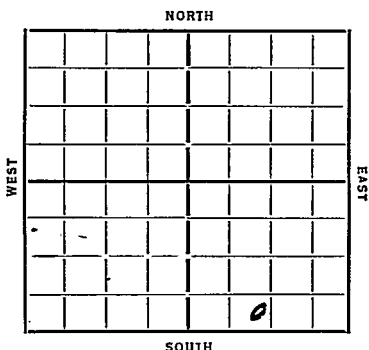

Date 1934 REPORT O. W. D. D

12/26 Location
1/3/35 Rig Rotary
1/10 Dlg 700 13" 164
1/17 " 2102
1/24 Chat 2887 T 17 3005
1/31 Dlg 3005
2/7 T 17 3354 7" 3552 WOC
2/14 Dlg 3354
2/21 Whole 3356 T 17 3360
5000 1000 acid
2/28 P 50 oil & 125 W.
3/7 Rgn to Decker
3/13 Whole 3356 T 17 3360
1000 acid
57 oil 145 Water.

COMPLETED

1935 O. W. D. D
5/8 Dlg 3364
5/16 WX 3411 50 3416-18 225 oil &
50 W 3" 1/2 hrs 3418 run 5"
5/23 5" 3404 Nil 3454 H.F.W. (over)

5/29 3455 100 W
dly 3482

6/6 PB 3405

6/13 PB 3391
1500 acid

6/19 Silicious 3454
T 7 3482
PB 3391
1500 acid
65 Oil
170 Water

COMPLETED

KANSAS

Map No. 43 Sec. 11 Twp. 19 R. 2WWell No. 8-DeckerShell pet Company

Contractor

FIRST REPORTS

Ft. from N. Line

330 Ft. from S. Line

Ft. from E. Line

1025 Ft. from W. Line

SECTION PLAT

Location ✓

Rig up

Drilling and Remarks:

RECORD

Cased.....in., ...ft.

Sand.....

Gas.....

Oil.....

Total Depth.....

PRODUCTION

1st 24 hrs. Nat.....

1st 24 hrs. after shot.....

Gas.....Cu. Ft.

Dry Hole.....

Abandoned.....

Date

17-26-31 192 ORVAL MANNSCHRECK Scout

Returned

Cards

Tracing






Map No. 43 Sec. 11 Twp. 19 R. 2W

Well No. 8-Decker

Shell pet. Company

.....Contractor

COMPLETED

SECTION PLAT

Ft. from N. Line

330 Ft. from S. Line

-----Ft. from E. Line

1025 Ft. from W. Line

2			
			0

RECORD

Location.....

Cased.....in., ...ft.

Rig up_____

~~Sand~~ Viola 3356

Drilling and Remarks:

Gas.....

1000 acid

Oil_____

Total Depth 3360

PRODUCTION

1st 24 hrs. Nat.

1st 24 hrs. after shot.....

Gas.....Cu. Ft.

Dry Hole.....

Abandoned.....

Date _____

313-35 192 ORVAL MANNSCHRECK Scout

ORVAL MANNSCHRECK Scout

[Large handwritten signature]

Returned	<i>[Signature]</i>
Cards	<i>[Signature]</i>
Tracing	<i>[Signature]</i>
France Map	<i>[Signature]</i>
Scarborough Map	<i>[Signature]</i>
Meedy Map	<i>[Signature]</i>
Scarborough Plot Book	<i>[Signature]</i>
Meedy Plot Book	<i>[Signature]</i>

Mapher son

KANSAS

Form 26-1114 Bks. 4-26
Map No. 43 Sec. 11 Twp. 19 R. 24

Well No. 8-Decker

Shell pit Company

Contractor

FIRST REPORTS

SECTION PLAT

			0

Ft. from N. Line

330 Ft. from S. Line

Ft. from E. Line

1025 Ft. from W. Line

QWDD

Location

Rig up

Drilling and Remarks:

OTN
3360

1029 3364

RECORD

Cased in, ft.

Sand

Gas

Oil

Total Depth

PRODUCTION

1st 24 hrs. Nat.

1st 24 hrs. after shot

Gas Cu. Ft.

Dry Hole

Abandoned

Date

ORVAL MANNSCHRECK

5-8-35 192

Scout



Returned	<i>CR</i>
Cards	
Tracing	<i>MUS</i>
France Map	<i>X</i>
Scarborough Map	<i>[Signature]</i>
Moody Map	<i>X</i>
Scarborough Plat Book	<i>[Signature]</i>
Moody Plat Book	

Map No. 43 Sec. 11 Twp. 19 R. 2 W.Well No. 8-Deckershell pit Company

Contractor

COMPLETED

SECTION PLAT

			0

Ft. from N. Line

330 Ft. from S. Line

Ft. from E. Line

990 Ft. from W. Line

O. W. D. D

RECORD

Location

Cased _____ in., _____ ft.

Rig up

Sand silicious 3454

Drilling and Remarks:

Gas _____

Oil _____

Total Depth 3482

PRODUCTION

1st 24 hrs. Nat. _____

1st 24 hrs. after shot _____

Gas _____ Cu. Ft.

Dry Hole _____

Abandoned _____

Date

L. VAL. MANN SCHRECK

6-19-35 192 Scout

Returned *CPA*
Cards *CPA*
Tracing *CPA*
France Map *X*
Scarborough Map *CPA*
Moody Map *X*
Scarborough Plat Book *1*
Moody Plat Book *CPA*