

Mc Pherson


Form 51-5M-5-34-Palace

Map No. KANSAS Sec. 11 Twp. 19 R. 2W

Well No. 7 Ricker Farm

Shell Pt.

Company

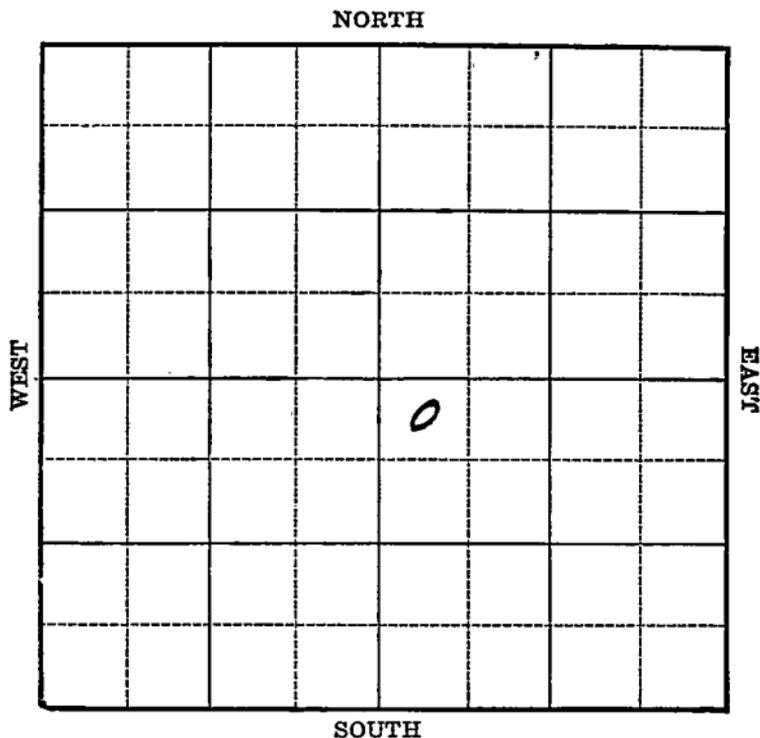

Location _____

Drilling Remarks _____

Rig Up _____

Drilling Remarks _____

RECORD

Cased _____ in. _____ ft.

Sand _____

Gas _____

Oil _____

Total Depth _____

PRODUCTION

1st 24 hrs. Nat. _____

1st 24 hrs. after shot _____

Gas _____ cu. ft.

Dry Hole _____


Abandoned _____

McPherson

Map No. KANSAS Sec. 11 Twp. 19 R. 2W

Well No. 7 Decker Farm
Shell Pet. Company

330 Ft. from N. Line
____ Ft. from S. Line
____ Ft. from E. Line
330 Ft. from W. Line

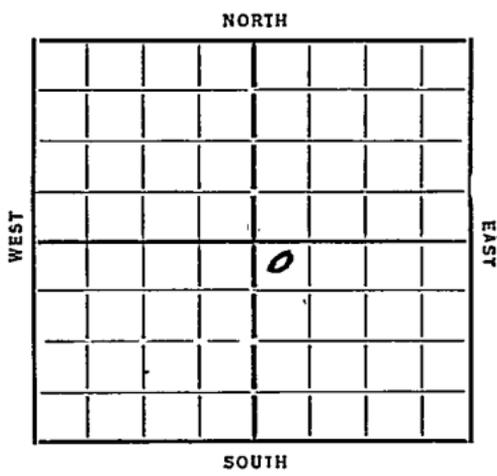

Date 1935

REPORT

1/16 Bldg Rot Rig
1/24 Bldg 600 13" 178
1/31 " 2440
2/7 " 3034 Chet 2883
2/14 3352 seg.
2/21 — 2/28 — 3/7 —
3/14 Bldg 3361 7" 3357
3/21 Viola 3368 500 oil 1000 acid
3/27 Viola 3368 T1 3380
1000 acid 385 Bbls 14 hrs.

COMPLETED

Map No. 43 Sec. 11 Twp. 19 R. 2W

Well No. 7-Decker

Shell pet Company

Contractor

FIRST REPORTS

SECTION PLAT

330 Ft. from N. Line

..... Ft. from S. Line

..... Ft. from E. Line

330 Ft. from W. Line

		0	

Location.....

Rig up.....

Drilling and Remarks:

Big Rot Rig

RECORD

Cased.....in.,ft.

Sand.....

Gas.....

Oil.....

Total Depth.....

PRODUCTION

1st 24 hrs. Nat.....

1st 24 hrs. after shot.....

Gas.....Cu. Ft.

Dry Hole.....

Abandoned.....

Date

1-16-37 192.....

ORVAL MANNSCHRECK

Scout

Map No. 43 Sec. 11 Twp. 19 R. 2W

Well No. 7-Decker

Shell pit Company

Contractor

COMPLETED

SECTION PLAT

330 Ft. from N. Line
..... Ft. from S. Line.
..... Ft. from E. Line
330 Ft. from W. Line

		0	

RECORD

Location.....

Rig up.....

Drilling and Remarks:

1000 acid

385 lbs
14 hrs

Cased..... in., ft.

Sand Viola 3368

Gas.....

Oil.....

Total Depth 3380

PRODUCTION

1st 24 hrs. Nat.....

1st 24 hrs. after shot.....

Gas..... Cu. Ft.

Dry Hole.....

Abandoned.....

Date

3-27-35 192

ORVAL MANNSCHECK Scout