

Mc Pherson


Form 51—5M—5-34—Palace

Map No. **KANSAS** Sec. 11 Twp. 19 R. 2^W

Well No. 5 Decker Farm

Shell Petroleum Company

NORTH

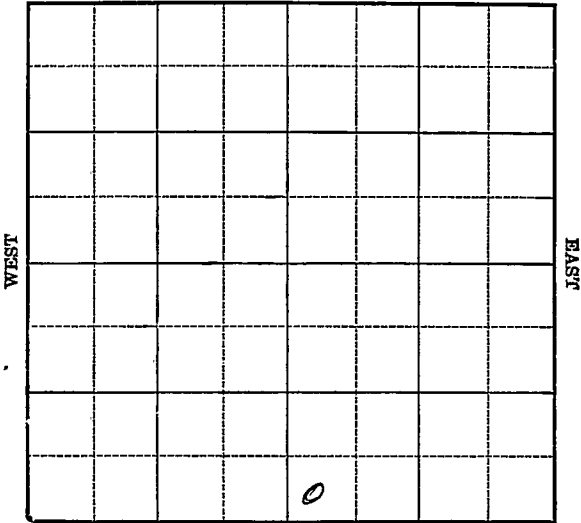

SOUTH

Location _____

Drilling Remarks _____

Rig Up _____

Drilling Remarks _____

RECORD

Cased _____ in. _____ ft.

Sand _____

Gas _____

Oil _____

Total Depth _____

PRODUCTION

1st 24 hrs. Nat. _____

1st 24 hrs. after shot _____

Gas _____ cu. ft.


Dry Hole _____

Abandoned _____

Mr. Thurson

Map No. KANSAS Sec. 11 Twp. 19 R. 24
Well No. 5 Ducker Farm
Shell Petroleum Company

150 Ft. from N. Line
150 Ft. from S. Line
300 Ft. from W. Line

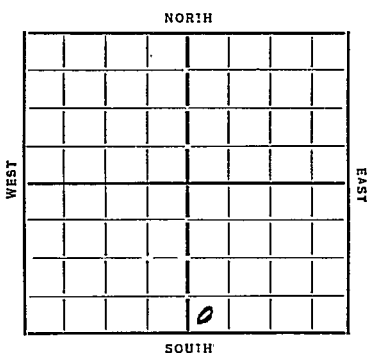

Date 1934

REPORT

8/29 Bldg. Rig
9/6 13" 164 T 2205 WOC
9/13 dly 1572
9/20 " 2767
9/27 TC 2900 log 3025
10/4 7" 3357 3362 Rust 3360.
10/11 Viola 3356 T 3360 dly plug
10/18 Viola Corrected 3362 T 73
350' oil 1000 acid
10/24 Viola 3362 T 3373
1000 acid 534 Bldg oil

COMPLETED

KANSAS

Map No. 43 Sec. 11 Twp. 19 R. 24

Well No. 2 - Ucker

Shell petroleum Company

Contractor

SECTION PLAT

FIRST REPORTS

Ft. from N. Line

150 Ft. from S. Line

Ft. from E. Line

300 Ft. from W. Line

3			
		0	

Location_____

Rig up _____

Drilling and Remarks:

Bedg Rig

RECORD

Cased _____ in _____ ft.

Sand_____

Gas

Oil_____

Total Depth_____

PRODUCTION

1st 24 hrs. Nat. _____

1st 24 hrs. after shot_____

Gas_____Cu. Ft.

Dry Hole_____

Abandoned _____

Date _____

8-29-37 19

ORVAL MANNSCHID Scout

Mapherson

Form 28 - 4M Bks. - 2-29

KANSAS

Map No. 43 Sec. 11 Twp. 19 R. 2W

Well No. 5- Decker

Shell petroleum Company

Contractor

COMPLETED

SECTION PLAT

		0	

 Ft. from N. Line

150 Ft. from S. Line

 Ft. from E. Line

300 Ft. from W. Line

Location

Rig up

Drilling and Remarks:

1000 and

*534 bbls
oil*

RECORD

Cased in., ft.

Sand Viola 3362

Gas

Oil

Total Depth 3373

PRODUCTION

1st 24 hrs. Nat.

1st 24 hrs. after shot

Gas Cu. Ft.

Dry Hole

Abandoned

Date

10-24-37 19

ORVAL MANNSCHRECK

Scout