


McPherson
Form 51-5M-2-29-34703
Map No. **KANSAS** Sec. *11* Twp. *19* R. *2w*
Well No. *4* *Dickie* Farm
McPherson & Shell Company

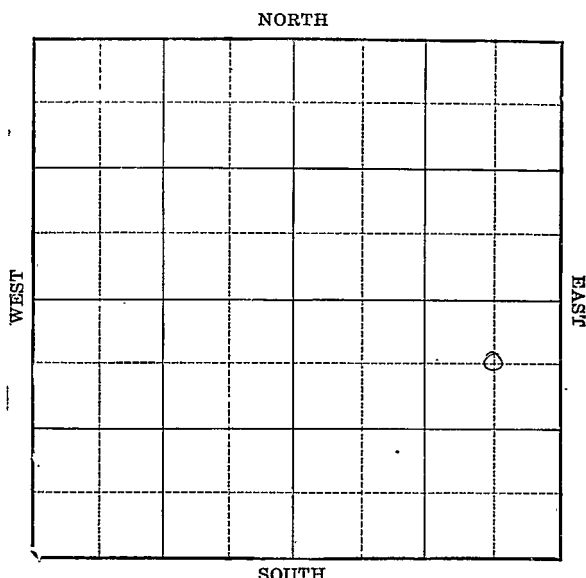

Location _____
Drilling Remarks _____

Rig Up _____
Drilling Remarks _____

RECORD

Cased _____ in. _____ ft.
Sand _____
Gas _____
Oil _____
Total Depth _____

PRODUCTION

1st 24 hrs. Nat. _____
1st 24 hrs. after shot _____
Gas _____ cu. ft. _____
Dry Hole _____
Abandoned _____

FORM 252A-5M-8-30-PETROL

Map No. **KANSAS** Sec.

Well.No.

Well. No. 4-

Farm

Company

NORTH

660

Ft. from N. Line



Ft. from S. Line

660

Ft. from E. Line

Ft. from W. Line

1931

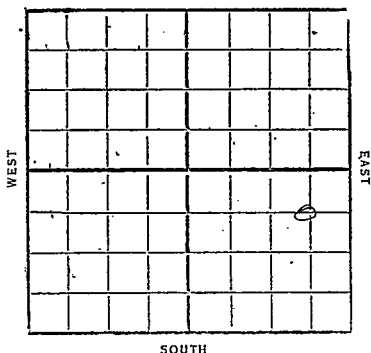

SOUTH

Date _____

REPORT

6/10

Pond

6/17

PS

6/24

By
H. O. G.

7/1

2820
Net 2895-

78
715

Gas 2914-15
TID 2915

11/5
7/27

57 # gas
87.5 # RP

1. 999

Comp.

Map No. **KANSAS** Sec. **11** Twp. **19** R. **2** ^W
 Well No. **43** **Decker**

McPherson & Aker Company
 Contractor

FIRST REPORTS

660 Ft. from N. Line

..... Ft. from S. Line

660 Ft. from E. Line

..... Ft. from W. Line

SECTION PLAT

			0

Location.....

Rig up..... **Pond**

Drilling and Remarks:

RECORD

Cased..... in., ft.

Sand.....

Gas.....

Oil.....

Total Depth.....

PRODUCTION

1st 24 hrs. Nat.....

1st 24 hrs. after shot.....

Gas..... Cu. Ft.

Dry Hole.....

Abandoned.....

Date

JUN 10 1931

CHAS. L. SHERWOOD

192

Scout

McPherson

KANSAS
 Map No. 43 Sec. 11 Twp. 19 R. 2 W
 Well No. 4 Decker

McPherson & Sheel Company
 Contractor

COMPLETE

SECTION PLAT

			0

660 Ft. from N. Line

Ft. from S. Line

660 Ft. from E. Line

Ft. from W. Line

Location

Rig up

Drilling and Remarks:

Gas 2914-15

875 # R.P.

RECORD

Cased in, ft.

Sand Chas 2895-2915

Gas

Oil

Total Depth 2915

PRODUCTION

1st 24 hrs. Nat.

1st 24 hrs. after shot

Gas 57 M Cu. Ft.

Dry Hole

Abandoned

Date

JUL 22 1931

192

CHAS. L. SHERWOOD

Scout