


Map No. KANSAS Sec. 11 Twp. 19 R. 2^w

Well No. #2 ~~#####~~ Decker Farm
M^cPherson O & S & Shell Company

1320 Ft. from N. Line
____ Ft. from S. Line
1320 Ft. from E. Line
____ Ft. from W. Line
1931

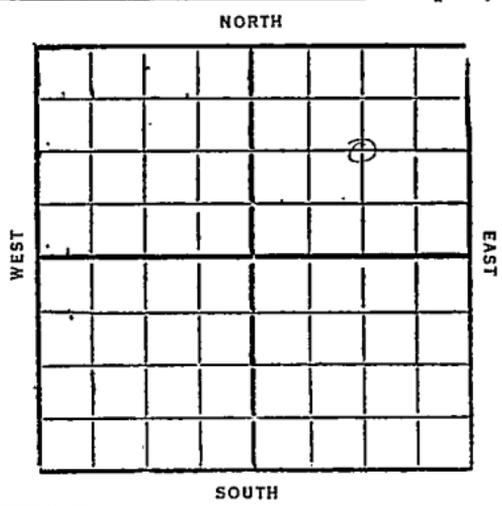

Date	REPORT
2/25	Log
3/4	Spud
3/11	Dug 470'
3/18	" 1770'
3/25	T.D. 2270' 11" 10"
4/1	Dug 2360'
4/8	Top of Chat 2895
4/15	Chat 2895-2920
	T.D. 2920
	38 M gas
	880# BP
	Comp.

Map No. **KANSAS** Sec. 11 Twp. 19 R. 2W

Well No. 1 B Tec per

McPherson Oil & Gas Storage Company

Contractor


SECTION PLAT

1820 Ft. from N. Line

..... Ft. from S. Line

1820 Ft. from E. Line

..... Ft. from W. Line

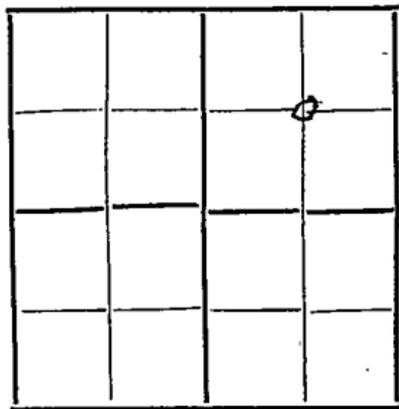

FIRST REPORTS

Location ✓

Rig up

Drilling and Remarks:

RECORD

Cased.....in.,ft.

Sand.....

Gas.....

Oil.....

Total Depth.....

PRODUCTION

1st 24 hrs. Nat.....

1st 24 hrs. after shot.....

Gas.....Cu. Ft.

Dry Hole.....

Abandoned.....

Date

FEB 25 1931

S. J. LEWIS

192.....

Scout

W. W. S.
W. W. S.

Returned	<i>WWS</i>
Cards	<i>WWS</i>
Tracing	<i>WWS</i>
France Map	
Scarborough Map	<i>WWS</i>
Moody Map	<i>WWS</i>
Scarborough Plat Book	
Moody Plat Book	

McPherson

43 **KANSAS** Sec. 11 Twp. 19 R. 2 W

Well No. 2 Decker

McPherson & Shell Company

Contractor

CORRECTION


1320 Ft. from N. Line

..... Ft. from S. Line

1320 Ft. from E. Line

..... Ft. from W. Line

SECTION PLAT

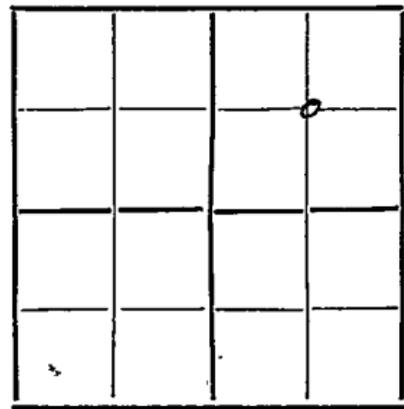

Location.....

Rig up.....

Drilling and Remarks:

Change Well No. to 40

RECORD

Cased..... in., ft.

Sand.....

Gas.....

Oil.....

Total Depth.....

PRODUCTION

1st 24 hrs. Nat.....

1st 24 hrs. after shot.....

Gas..... Cu. Ft.

Dry Hole.....

Abandoned.....


Date

APR 15 1931

192

CHAS. L. SHERWOOD

Scout

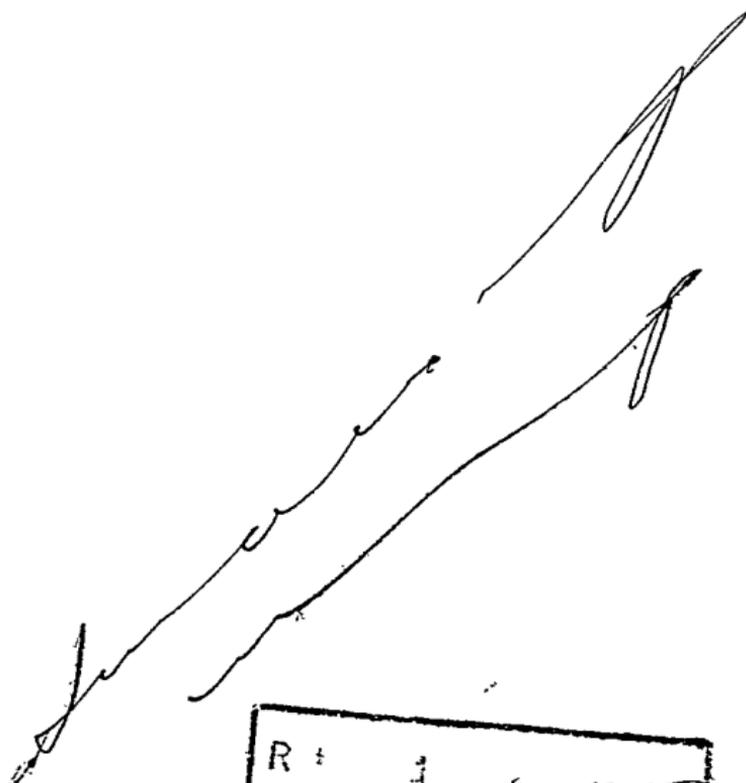

R #	1
Ca	<i>[Handwritten signature]</i>
Tract #	<i>CRB</i>
France Map	<i>[Handwritten mark]</i>
Scarborough Map	<i>[Handwritten mark]</i>
Moody Map	<i>[Handwritten mark]</i>
Scarborough Plat Book	<i>[Handwritten mark]</i>
Moody Plat Book	<i>[Handwritten mark]</i>

McPherson

43 **KANSAS** Map No. Sec. 11 Twp. 19 R. 2^W

Well No. 2 *Decker*


McPherson & Shell Company

Contractor

COMPLETE

1320 Ft. from N. Line
 Ft. from S. Line
 1320 Ft. from E. Line
 Ft. from W. Line

SECTION PLAT

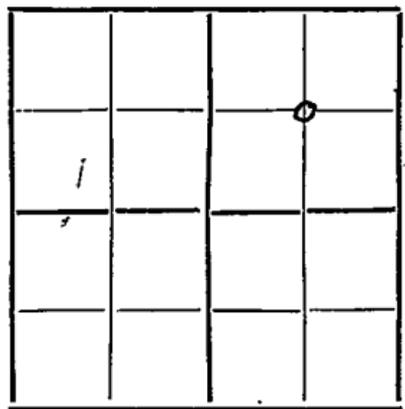

Location.....
 Rig up.....
 Drilling and Remarks:

880 # R.P.

RECORD


Cased in., ft.
 Shot 2895-2920
 Sand
 Gas.....
 Oil.....
 Total Depth 2920

PRODUCTION

1st 24 hrs. Nat.....
 1st 24 hrs. after shot.....
 Gas 38 M Cu. Ft.
 Dry Hole.....
 Abandoned.....

Date
 APR 15 1931

192 **CHAS. L. SHERWOOD** Scout

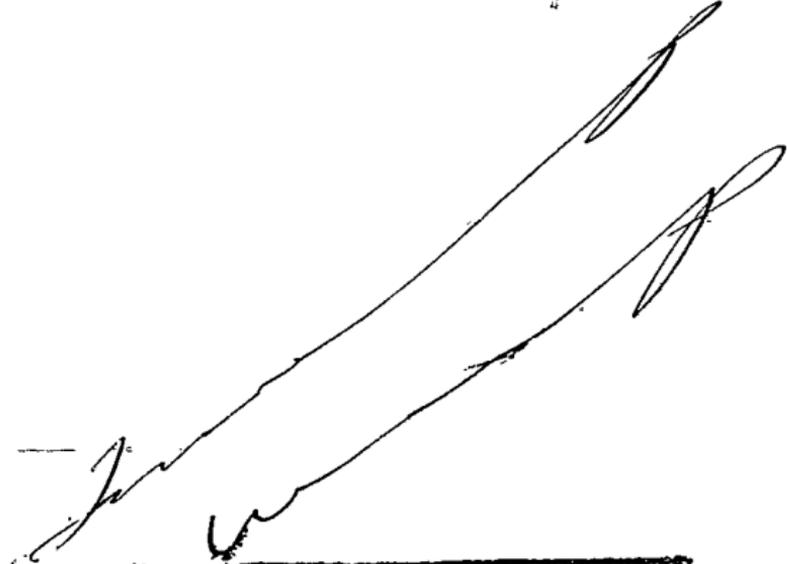

Returned

Cards

Tracing

France Map

Scarborough Map

Moody Map

Scarborough Plot Book

Moody Plot Book