


Mc Pherson
19 2nd

Map No. KANSAS Sec. 11 Twp. 19 R. 2nd

Well No. 5 - Full Shell Pit Farm _____ Company _____

NORTH

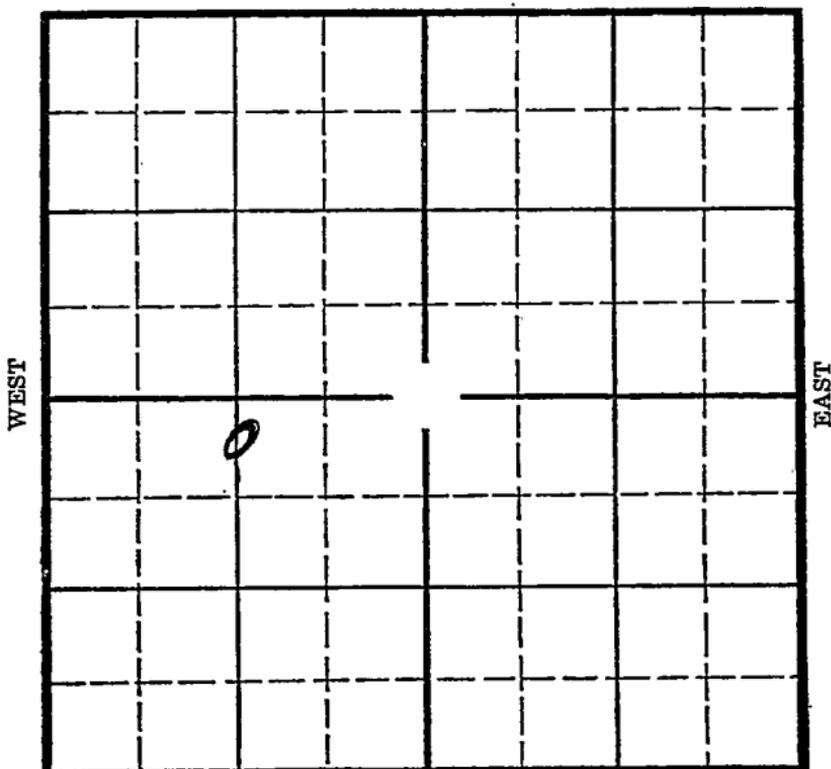

SOUTH

Location _____

Drilling Remarks _____

Rig Up _____

Drilling Remarks _____

RECORD

Cased _____ in. _____ ft.

Sand _____

Gas _____

Oil _____

Total Depth _____

PRODUCTION

1st 24 hrs. Nat. _____

1st 24 hrs. after shot _____

Gas _____ cu. ft.

Dry Hole _____

Abandoned _____

Map No. 43 Sec. 11 Twp. 19 R 2W

Well No. 5-Hall

Shell pet. Company

Contractor

FIRST REPORTS

SECTION PLAT

330 Ft. from N. Line

..... Ft. from S. Line

1337 Ft. from E. Line

..... Ft. from W. Line

	o		

Location.....

Rig up.....

Drilling and Remarks:

Mooring

RECORD

Cased..... in., ft.

Sand.....

Gas.....

Oil.....

Total Depth.....

PRODUCTION

1st 24 hrs. Nat.....

1st 24 hrs. after shot.....

Gas..... Cu. Ft.

Dry Hole.....

Abandoned.....

Date

8-7-35 192.....

ORVAL MANNSTRECK

Scout

Myerson

Map No. 43 Sec. 11 Twp. 19 R. 24

Well No. 5-Hull

Shell pit. Company _____

Contractor _____

COMPLETED


SECTION PLAT

330 Ft. from N. Line

_____ Ft. from S. Line

1337 Ft. from E. Line

_____ Ft. from W. Line

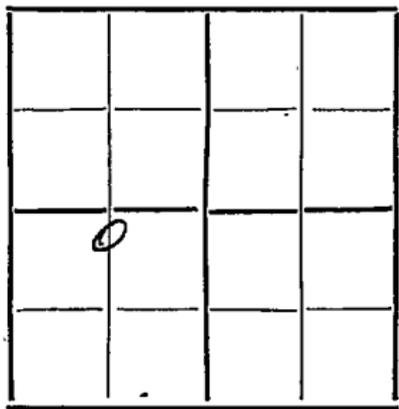

Location _____

Rig up _____

Drilling and Remarks:

1000 and

245
ppb

RECORD

Cased _____ in. _____ ft.

Sand Dolomite 3362

Gas _____

Oil _____

Total Depth 3378

PRODUCTION

1st 24 hrs. Nat. _____

1st 24 hrs. after shot _____

Gas _____ Cu. Ft.

Dry Hole _____

Abandoned _____

Date _____

9-25-35 192

ORVAL WANNSCHECK

Scout