


Section 11 Township 19 Range 15-W

Well No. #1 Gunn

Company Harbar Drlg. et al

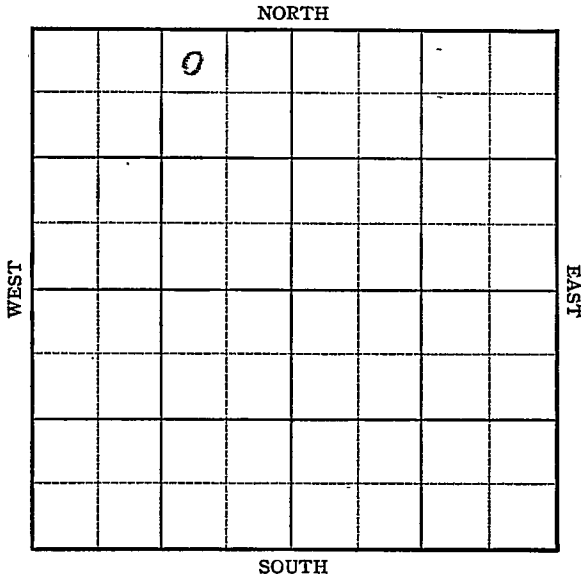

Sec. 11 Twp. 19 R. 15W

Well No. #1 Gunn Farm

Harbar Drlg. et al Company

Mertens


330 Ft. from N. Line

\_\_\_\_\_ Ft. from S. Line

990 Ft. from E. Line

\_\_\_\_\_ Ft. from W. Line

NW NE NW

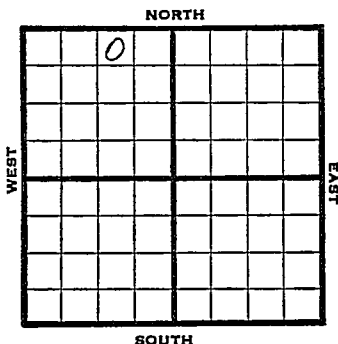

1946 Elev. 1994' REPORT

1/9 Location

1/17 R U R

1/24 Anhy 968' 10" - 985'

Drlg. 1155'

1/31 Drlg. 2915'

2/7 SD 3348'

2/14 Lans. 3312' SO BKC 3554'

Cong 3564' Reagan 3611-18' T.D. SO

5" - 3613' RUST.

2/21 T.D. 3620' Shot 4 qts.

No. increase.

2/27 Reagan 3611

5" @ 3613

TD 3648'

ABANDONED

KANSAS Kansas Pool Name Mertens  
 Map No. 82 Sec. 11 Twp. 19 R. 15W

Well No. 1 Gunn

Harbar Drlg. etal Company

FIRST REPORT Contractor

NW NE NW

SECTION PLAT

330 Ft. from N. Line

         Ft. from S. Line

990 Ft. from E. Line

         Ft. from W. Line

	o		

Barton County

Location X

Rig up         

Drilling and Remarks:

RECORD

Cased          in,          ft.

Sand         

Gas         

Oil         

Total Depth         

PRODUCTION

1st 24 hrs. Nat.         

1st 24 hrs. after shot         

Gas          Cu. Ft.

Dry Hole         

Abandoned         

Date

JAN 9 1945 19

S. J. LEWIS Scout

Kansas Pool Name MertensMap No. 82 Sec. 11 Twp. 19 R. 15WWell No. 1 GurmHarbar Drlg. etal Company

ABANDONED

Contractor

NW NE NW

*E 11984*  
SECTION PLAT330 Ft. from N. Line         Ft. from S. Line990 Ft. from E. Line         Ft. from W. Line

	0		

Barton County

Location         Rig up         

Drilling and Remarks:

*Reagan 3611*  
*5" 3613*

## RECORD

Cased          in.,          ft.Sand         Gas         Oil         Total Depth 3648

## PRODUCTION

1st 24 hrs. Nat.         1st 24 hrs. after shot         Gas          Cu. Ft.Dry Hole         Abandoned         

Date

FEB 27 1946 19S. J. LEWIS Scout