

KANSAS

FORM 51 5M 6-46 PETROL

Rush county

Section 11 Township 19 Range 16-W

Well No. #1, Oetkin

Company Bill Cross et al

NORTH

				0			

SOUTH

WEST

EAST

10

KANSAS

Rush ✓

Sec. 11 Twp. 19 R. 16W

Well No. #1 Oetkin Farm

Bill Cross etal Company

Wildcat


330 Ft. from N. Line

 Ft. from S. Line

 Ft. from E. Line

330 Ft. from W. Line

NW SE

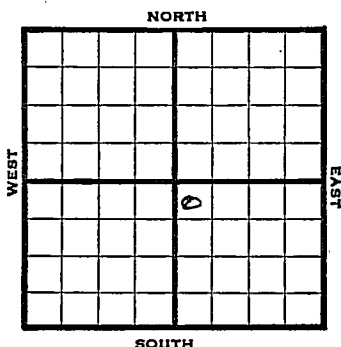

1946

Elev. 2026'

REPORT

11/6 Drlg 123'
11/12 10" @ 1080'
Anhy 1080'
Drlg 2380'
11/20 Lans 3415'
BKC 3636'
Congl 3636'
Reagon 3770'
TD 3775'

ABANDONED

Map No. 81 Sec. 11 Twp. 19 R. 16W

Well No. 1 Oetkin

Bill Cross etal. Company

FIRST REPORT Contractor

NW SE


SECTION PLAT

330 Ft. from N. Line

 Ft. from S. Line

 Ft. from E. Line

330 Ft. from W. Line

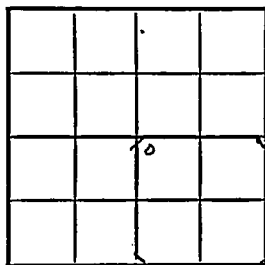

Rush County

Location

Rig up

Drilling and Remarks:

drlg. 123'

RECORD

Cased in., ft.

Sand

Gas

Oil

Total Depth

PRODUCTION

1st 24 hrs. Nat.

1st 24 hrs. after shot

Gas Cu. Ft.

Dry Hole

Abandoned

Date

NOV 6 1946 19 S. J. LEWIS Scout

Map No. 81 Sec. 11 Twp. 19 R. 16W

Well No. 1 Oetkin

Bill Cross et al. Company

ABANDONED

Contractor

NW SE

E12026
SECTION PLAT

330 Ft. from N. Line

 Ft. from S. Line

 Ft. from E. Line

330 Ft. from W. Line

		6	

Rush County

Location

Rig up

Drilling and Remarks:

Lane 3415
BK 2686
Cong 2626
Reagan 2778

RECORD

Cased in., ft.

Sand

Gas

Oil

Total Depth 2725

PRODUCTION

1st 24 hrs. Nat.

1st 24 hrs. after shot

Gas Cu. Ft.

Dry Hole

Abandoned

Date

NOV 20 1946 19

S. J. LEWIS

Scout