

30-19-12W


WELL LOG BUREAU—KANSAS GEOLOGICAL SOCIETY  
508 East Murdock, Wichita, Kansas

Company- W. L. HARTMAN  
Farm- Kohler No. 12

SEC. 30 T. 19 R. 12W  
NW SE SW SE

Total Depth. 3351  
Comm. 7-3-53 Comp. 7-20-53  
Shot or Treated.  
Contractor. H & H Drilling Co.  
Issued. 11-21-53

County Barton KANSAS

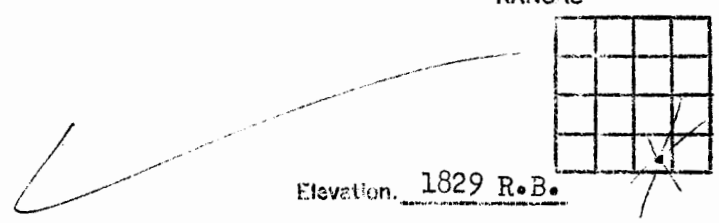

Elevation. 1829 R.B.

Production. Sunt in Gas Well

Figures indicate Bottom of Formations.

CASING:  
8 5/8" 190' cem. w/150 sx  
5 1/2" 3351' cem. w/200 sx

clay	20
sand	150
blue shale	191
shale	280
redbed	600
blue shale	630
redbed	670
shale	1485
lime & shale	1635
lime	1865
lime & shale	2080
shale	2315
shale & lime	2660
lime	2740
lime & shale	2756
lime	2955
lime & shale	3000
lime	3351
Rotary Total depth	

Scout Tops:	
Topeka	2725
Toronto	2982
Brown lime	3073
Lansing	3088
BKC	3316
Arbuckle	3336