


Section 12 Township 19 Range 12W

Well No. 13 Kultgen "A"

Company Aladdin Petr.

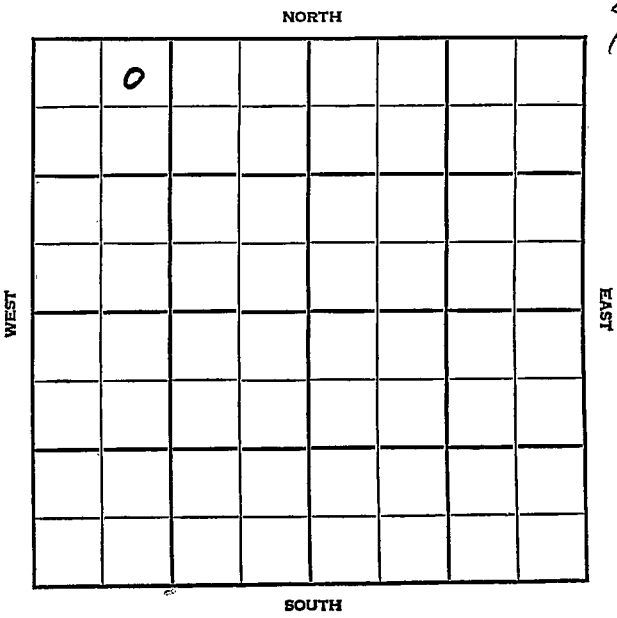

Barton

KANSAS

|      |      |     |
|------|------|-----|
| SEC. | TWP. | R.  |
| 12   | 19   | 12W |

WELL NO.

#13 Kultgen "A"

FARM

COMPANY

Aladdin Pet.

CONTRACTOR

Lewis Drlg.

Cheyenne View Pool

330

Ft. from N. Line

Ft. from S. Line

Ft. from E. Line

990

Ft. from W. Line

NE NW NW

|  |   |  |  |  |  |  |  |  |  |
|--|---|--|--|--|--|--|--|--|--|
|  |   |  |  |  |  |  |  |  |  |
|  | 0 |  |  |  |  |  |  |  |  |
|  |   |  |  |  |  |  |  |  |  |
|  |   |  |  |  |  |  |  |  |  |
SOUTH

|      | ELEVATION | REPORT |
|------|-----------|--------|
| 1954 | 1822'     |        |

9/1

Spud 8-27-54

8" @ 235'

11/3

Drlg. 2205'

Spud 8-27-54

Oil Well

TD 3428'

8" @ 235'

Heeb 2964', Br. Lime 3082', Lans 3098'

Arb. 3416'

TD 3420'

5" @ 3417'

DD 3428 wtr. SP 3375 24/ 3298-3307

dry 17/ 3311-17 dry 24/ 3319-28

2000 A S/ 30 boph

Comp 25 bopd.

COMPLETED

County **Barton** State **Kansas**  
 Sec. **12** (Blk.) **19** (Sur.) **12W** Map No.  
 (Twp.)  
 Operator **Aladdin Pet.**  
 Well No. **13** Farm **Kultgen "A"**  
 Elev. Location **NE NW NW**

|  |   |  |  |  |  |  |  |
|--|---|--|--|--|--|--|--|
|  | 0 |  |  |  |  |  |  |
|  |   |  |  |  |  |  |  |
|  |   |  |  |  |  |  |  |
**FIRST REPORT**

**330** Ft. From **N** Line **NW**  
**990** Ft. From **W** Line Quarter

1st. Report **SEP 1 1954**

Completion

Remarks

**Lewis Drlg. - Contr.**

Spudding Date **8-27-54**

Drlg. Data

**Cheyenne View Pool**

**8" @ 235 drlg. 2205**

**FABEN GILSTRAP**

County Barton State KansasSec. 12 (Blk. Twp.) 19 (Sur. Rge.) 12W Map No. \_\_\_\_\_Operator Aladdin Pet.Well No. 13 Farm Kultgen "A"Elev. 1822 Location NE NW NW

|  |   |  |  |  |  |  |
|--|---|--|--|--|--|--|
|  | o |  |  |  |  |  |
|  |   |  |  |  |  |  |
|  |   |  |  |  |  |  |
330 Ft. From N Line NW990 Ft. From W Line Quarter

1st. Report \_\_\_\_\_

Completion NOV 3 1954Remarks Cheyenne View PoolLewis Drlg. - Contr.Spudding Date 8-27-54Drlg. Data Oil well TD 34288" @ 235 Heeb. 2964 Br. lime 3082Lans. 3098 Arb. 3416 TD 3420 5" @ 3417DD 3428 wtr. SP 3375 24/ 3298-3307dry 17/ 3311-17 dry 24/ 3319-282000 A S/ 30 boph Comp. 25 bopd

FABEN GILSTRAP