


Section 12 Township 19 Range 12W

Well No. 14 Kultgen "A"

Company Aladdin Petr.

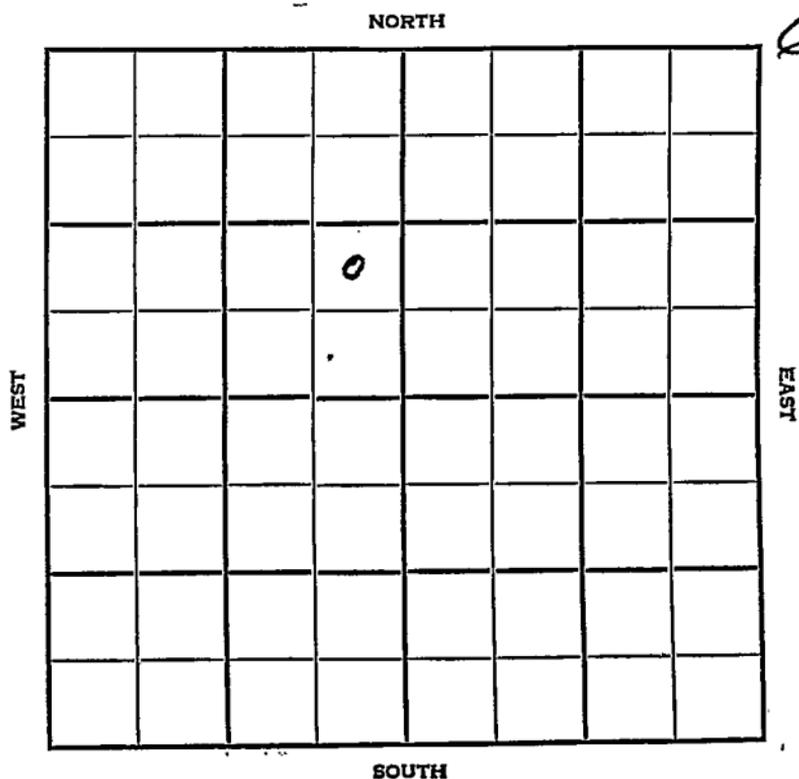

Barton

KANSAS

SEC.	TWP.	R.
12	19	12W


WELL NO. #14 Kultgen "A" FARM

COMPANY Aladdin Pet.

CONTRACTOR Lewis Drlg.

Cheyenne View Pool^{NORTH}

_____ Ft. from N. Line
 990 _____ Ft. from S. Line
 330 _____ Ft. from E. Line
 _____ Ft. from W. Line

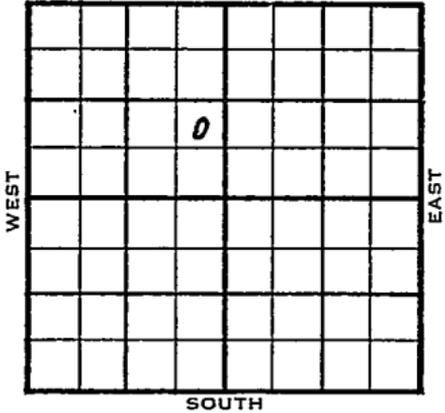

NE SE NW

1954	ELEVATION 1807'	REPORT
------	--------------------	--------

9/1
11/3

Location
 Spud 9-8-54
 Oil Well
 TD 3398'
 8" @ 246'
 Heeb 2951', Br. Lime 3069', Lans 3086'
 Arb 3396'
 TD 3397'
 5" @ 3397'
 DD 3398' HFW SP 3371
 24/ 3330-38 24/ 3338-46 24/ 3346-54
 2000 A S/ 35 boph 2 hr.
 Comp 25 bopd.

COMPLETED

