


Section 12 Township 19 Range 12W

Well No. #9 ~~12~~ Kultgen (A)

Company Alladdin & Crowe

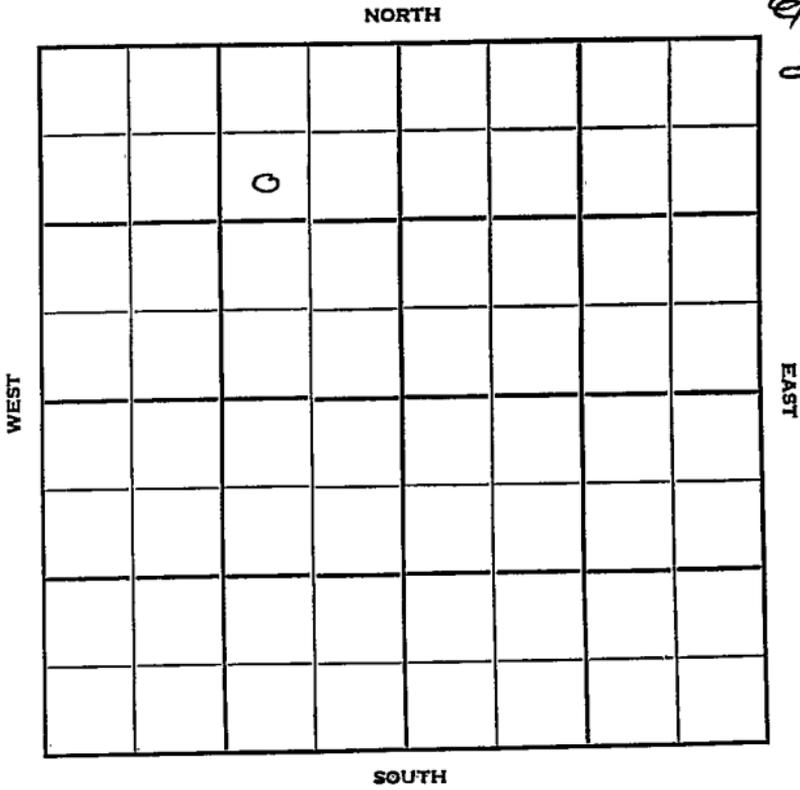

Barton

Sec. 12 Twp. 19 R. 12W ✓

Well No. #1 Kultgen (A) Farm

Aladdin & Crowe Company

Crowe Contractor

Cheyenne


990 Ft. from N. Line

_____ Ft. from S. Line

990 Ft. from E. Line

_____ Ft. from W. Line

SW NE NW

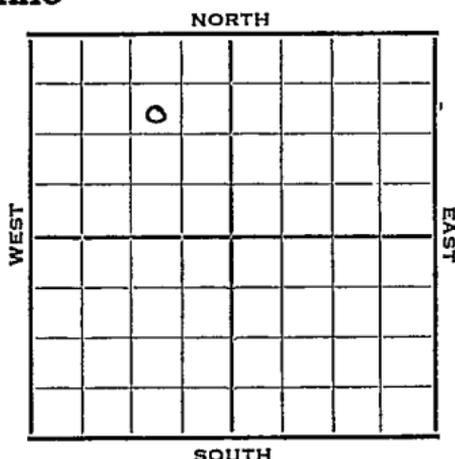

1952

Elev. 1808'

REPORT

3/5

Location

3/11

"

3/19

8" @ 242'

Anhy 630'

Drlg. 1120'

3/25

DST 2807-2905' in Topeka 1 hr, 15' oily M, 60' wtry O & GCM, 750#

Heeb 2947' Br Li 3062' KC 3078'

Drlg. 3308'

4/1

Arb. 3387' RTD 3391' 4" @ 3390

DD to 3394 Test 1/2 BOPH To A

4/9

1000 A Test 4 BOPH PB 3319

21/3308-15 46/3286-3302

17/3275-81 17/3266-72 NS

2000 A F 35 BOPH Testing

4/23

P/240 BOPD

4/30

Spud 3-15-52

Oil well TD 3394' 8" @ 242'

Anhy 630'

DST 2807-2905 open 1 hr. rec 15' O & GCM, 60' wtry O & GCM

Heeb 2947' Br. lime 3062' KC 3078'

Arb. 3387' TD 3391' 4" @ 3390

DD 3394 1/2 BOPH 1000 A 4 BOPH

PB 3319' 21/3308-15 46/3286-3302

17/3275-81 17/3266-72 2000 A

F/35 BOPH

Comp. 240 BOPD

COMPLETED

Kansas

Map No. _____ Sec. 12 Twp. 19 R. 12W

Well No. 9 Kultgen "A"

Aladdin & Crowe Company

CONCRECTION Contractor

SW NE NW

SECTION PLAT

990 Ft. from N. Line

_____ Ft. from S. Line

990 Ft. from E. Line

_____ Ft. from W. Line

	0		

Barton County

Location _____

Rig up _____

Drilling and Remarks:

Reported

#1 Kultgen "A"

RECORD

Cased _____ in., _____ ft.

Sand _____

Gas _____

Oil _____

Total Depth _____

PRODUCTION:

1st 24 hrs. Nat. _____

1st 24 hrs. after shot _____

Gas _____ Cu. Ft.

Dry Hole _____

Abandoned _____

Date

MAR 19 1952

J. G. MCGEHEE

Scout

County Barton State Kansas

Sec. 12 (Blk.) 19 (Sur.) 12W Map No.

Operator Aladdin & Crowe Drlg.

Well No. 9 Farm Kultgen "A"

Elev. 1808 Location SW NE NW

990 Ft. From N Line NW

990 Ft. From E Line Quarter

1st. Report

Completion APR 30 1952

Remarks Cheyenne Pool

Crowe Drlg. - Contr.

Spudding Date 3-15-52

Drlg. Data Oil well TD 3394

8" @ 242 Anhy 630 DST 2807-2905

open 1 hr. Rec. 15' o & gcm 60' wtry

o & gcm Heeb. 2947 Br. lime 3062

KC 3078 Arb. 3387 TD 3391 4" @ 3390

DD 3394 1/2 boph 1000 A 4 boph

PB 3319 21/ 3308-15 46/ 3286-3302

17/ 3275-81 17/ 3266-72 2000 A

F/ 35 boph Comp. 240 bopd

J. G. McGEHEE