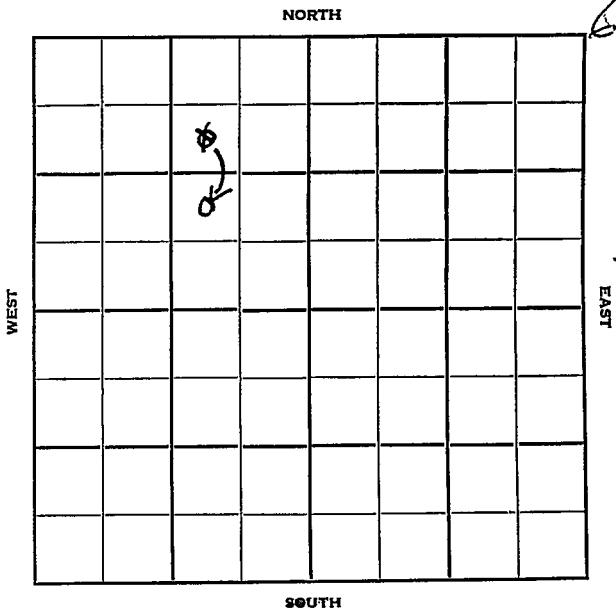


Section 12 Township 19 Range 12 WWell No. # 8 Kultgen "A"Company Alladdin & Crowe

Barton

KANSAS

Sec. 12 Twp. 19 R. 12 W

Well No. # 8 Kultgen "A" Farm

Aladdin & Crowe Drlg.

Company

Cheyenne View Pool

Contractor


990 Ft. from N. Line

990 Ft. from S. Line

990 Ft. from E. Line

 Ft. from W. Line

NW SE NW
SW NE NW

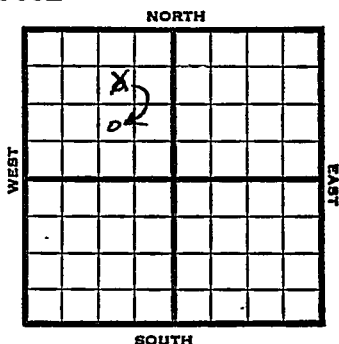

1951

Elev. 1803'

REPORT

12/12

Location

1952

1/16

Spud 12-12-51
8" @ 240

Anhy 605 Br Li 3064

Lans. 3081

DST 3083-3154 open 15 min.

Rec. 30' GCM 150' HO&GCM

DST 3206-61 open $\frac{1}{2}$ hr. rec. 590'

oil Arb. 3378 TD 3382

5" @ 3380 DD to 3393 1000 A

50 BO 8 hr. Comp. 248 BOPD

COMPLETED

Map No. _____ Sec. 12 Twp. 19 R. 12W

Well No. 8 Kultgen "A"

Aladdin & Crowe Company

CONSTRUCTION Contractor

NW SE NW

SECTION PLAT

	o		

_____ Ft. from N. Line

990 Ft. from S. Line

990 Ft. from E. Line

_____ Ft. from W. Line

Barton County

RECORD

Location _____

Cased _____ in., _____ ft.

Rig up _____

Sand _____

Drilling and Remarks:

Gas _____

Reported

Oil _____

SW NE NW

Total Depth _____

PRODUCTION

1st 24 hrs. Nat. _____

1st 24 hrs. after shot _____

Gas _____ Cu. Ft.

Dry Hole _____

Abandoned _____

Date

DEC 12 1951

19

J. E. TYRA

Scout

County Barton State Kansas
 Sec. 12 (Blk. Twp.) 19 (Sur. Rge.) 12W Map No. _____
 Operator Aladdin & Crowe Drlg.
 Well No. 8 Farm Kultgen "A"
 Elev. _____ Location SW NE NW

5

FIRST REPORT


990 Ft. From N Line NW
990 Ft. From E Line Quarter
 1st. Report DEC 1 2 1951
 Completion _____
 Remarks _____
 Spudding Date _____

Drlg. Data Cheyenne View Pool
Location

See correction attached

J. E. TYRA

County Barton State Kansas
 Sec. 12 (^{Blk.}_{Twp.}) 19 (^{Sur.}_{Rge.}) 12W Map No. _____
 Operator Aladdin & Crowe Drlg.
 Well No. 8 Farm Kultgen "A"
 Elev. 1803 Location NW SE NW

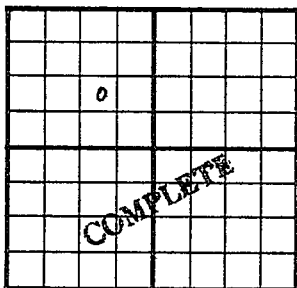

990Ft. From S Line NW
990Ft. From E Line Quarter
 1st. Report _____
 Completion JAN 16 1952
 Remarks Cheyenne View Pool

Spudding Date 12-12-51
 Drlg. Data Oil well TD 3393

8" @ 240 Anhy 605 Br. lime 3064

Lans. 3081 DST 3083-3154 open 15 min.

Rec. 30' gcm 150' ho & gcm DST 3206-61

open $\frac{1}{2}$ hr. Rec. 590' oil Arb. 3378

TD 3382 5" @ 3380 DD to 3393

1000. A 50 bo 8 hr. Comp. 248 bopd

J. E. TYRA