

Barton

19

12W

Section 12 Township 19 Range 12W

Well No. #6 Kultgen "A"


Company Aladdin et al

NORTH

6

WEST

EAST

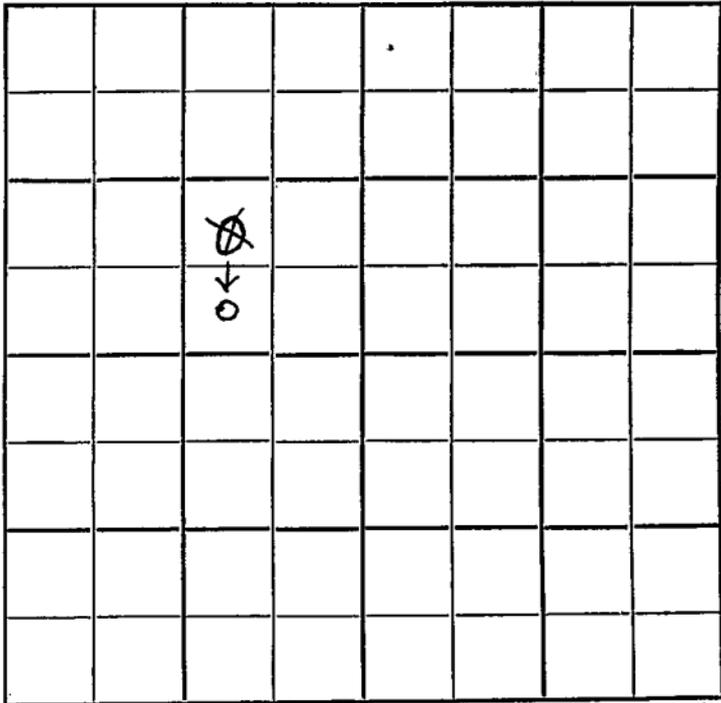

SOUTH

Sec. 12 Twp.

Well No. #6 Kultgen "A" Farm

Aladdin et al Company

Contractor

Cheyenne View Pool

Ft. from N. Line

336'


Ft. from S. Line

990'

Ft. from E. Line

990'

Ft. from W. Line

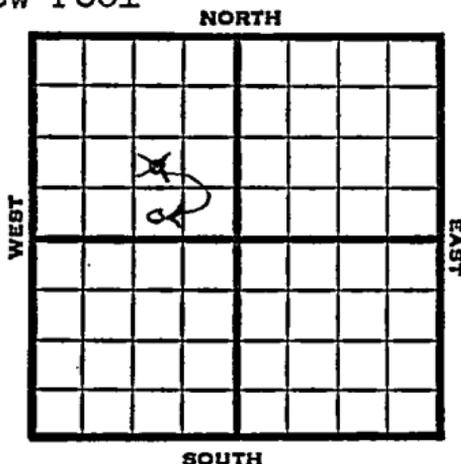

~~NW SE NW~~
SW SE NW

1951

Elev. 1799' REPORT

1/3
3/28

Location
Spud 2-8-51
Oil Well TD 3376
8" @ 237 Anhy 620-55'
Br Lime 3060 Lans. 3078'
DST 3078-3151 opn 15 min.
Rec. 230' hocm
DST 3200-56 opn 1/2 hr Rec. 1020' oil
60' water
Arb. 3349-55 5" @ 3353 TD 3376
S/5 boph SP 3334
30/3224-34 33/3205-16 2000 A
S/35 boph Comp. 267 bopd 3% water.

COMPLETED

Kansas

Form 26 200 Bks. 8-50 Petrol

Map No. _____ Sec. 12 Twp. 19 R. 12W


Well No. 6 Kultgen "A"

Aladdin Pet. _____ Company

~~CORRECTION~~ Contractor

SW SE NW

SECTION PLAT

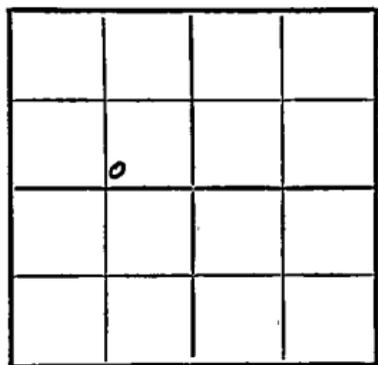

_____ Ft. from N. Line

330 Ft. from S. Line

990 Ft. from E. Line

_____ Ft. from W. Line

Barton County

RECORD

Location _____

Rig up _____

Drilling and Remarks:

Reported
NW SE NW

Cased _____ in., _____ ft.

Sand _____

Gas _____

Oil _____

Total Depth _____

PRODUCTION

1st 24 hrs. Nat. _____

1st 24 hrs. after shot _____

Gas _____ Cu. Ft.

Dry Hole _____

Abandoned _____

Date

FEB 14 1951 19

J. E. TYRA

Scout

