


Section 12 Township 19 Range 12-W

Well No. #5 Kultgen "A"

Company Alladdin & Crowe

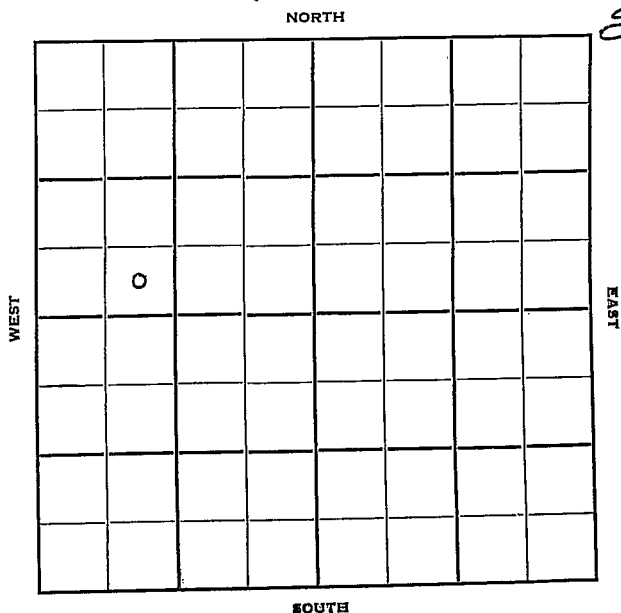

Barton

KANSAS ✓

Sec. 12 Twp. 19 R. 12W

Well No. #5 Kultgen "A" Farm

Aladdin & Crowe Company

Cheyenne View Pool Contractor


Ft. from N. Line

330' Ft. from S. Line

Ft. from E. Line

990' Ft. from W. Line

SE SW NW

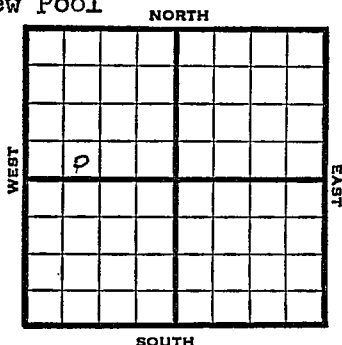

1950

Elev. 1813' REPORT


9/20

RUR

11/29

Spud 9-20-50
Oil Well TD 3399
8-5/8" @ 242 Anhy 650-85
DST 2888-2911 opn 45 min.
Rec. 90' ho gcm 5' free oil
Heeb. 2952 Br. Lime 3067
DST 3086-3155 opn 11 min.
Rec. 375' ocm
Lans. 3084' Cong. 3351
Arb. 3390-93
5" @ 3392' TD 3399 B/1 boph
1000 A P/3 boph Comp. 128 bopd

COMPLETED

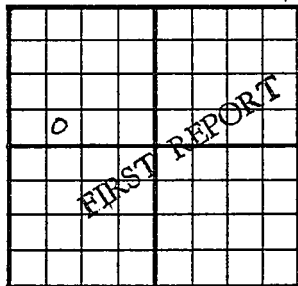County Barton State KansasSec. 12 (Blk. Twp.) 19 (Sur. Rge.) 12W Map No.Operator Aladdin & CroweWell No. 5 Farm Kultgen "A"Elev. Location SE SW NW330 Ft. From S Line NW990 Ft. From W Line Quarter1st. Report SEP 20 1950

Completion


Remarks

Spudding Date

Drlg. Data Cheyenne View PoolR U R

J. E. TYRA

County Barton State Kansas
 Sec. 12 (Blk.) 19 (Sur.) 12W Map No.
 Operator Aladdin & Crowe Drlg.
 Well No. 5 Farm Kultgen "A"
 Elev. 1813 Location SE SW NW

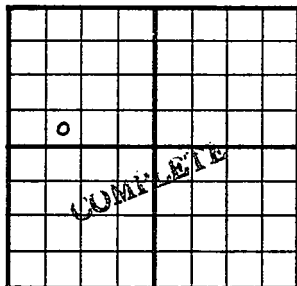

330 Ft. From S Line NW
990 Ft. From W Line Quarter
 1st. Report
 Completion NOV 29 1950
 Remarks Cheyenne View Pool
 Spudding Date 9-20-50

Drlg. Data Oil well TD 3399
8 5/8" @ 242 Anhy 650-85 DST 2888-2911
open 45 min. Rec. 90' ho ' gcm 5' free
oil Heeb. 2952 Br. lime 3067
DST 3086-3155 open 11 min. Rec. 375' ocm
Lans. 3084 Cong. 3351 Arb. 3390-93
5" @ 3392 TD 3399 B/ 1 boph 1000 A
P/ 3 boph Comp. 128 bopd

J. E. TYRA