


FORM 51 25M 3-49 PETROL Barton

Section 12 Township 19 Range 12W

Well No. #11 Kultgen (A)

Company Aladdin & Crow

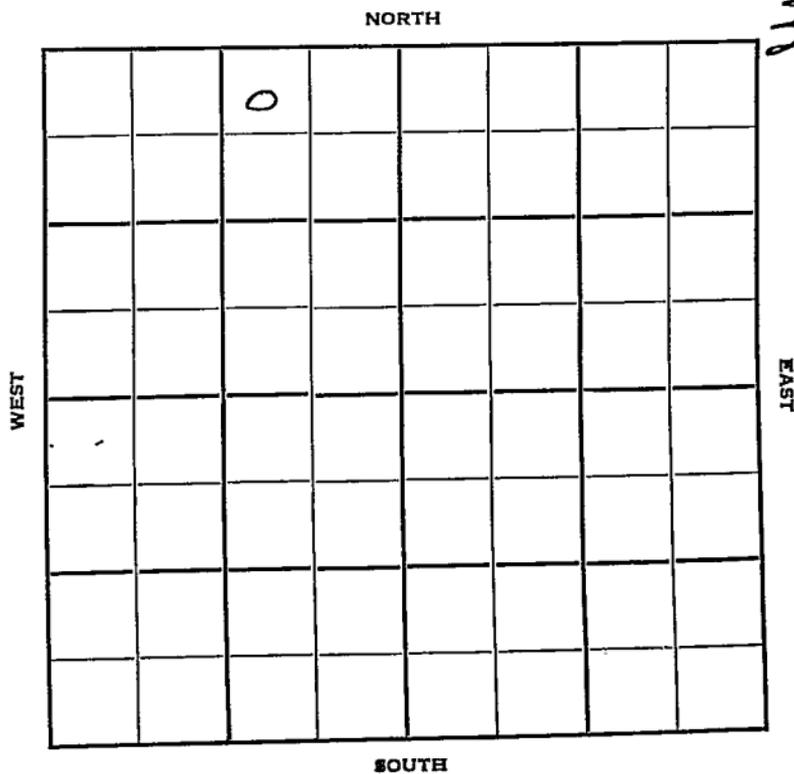

Sec. 12 Twp. 19 R. 12W

Well No. #11 Kultgen "A" Farm

Aladdin & Crow Company

Crow - Contr. Contractor


330' Ft. from N. Line

Ft. from S. Line

990' Ft. from E. Line

Ft. from W. Line

NW NE NW

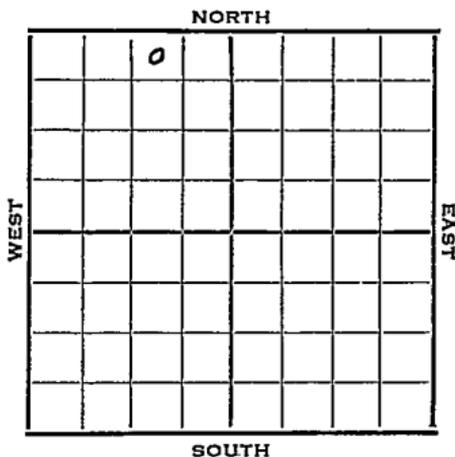

1952 Elev. 1819' REPORT

- 5/7 Spud 5-2-52
8" @ 245
Anhy 635
Drlg. 1935'
- 5/14 DST 2899-2920 in Topeka, No top 1 hr.
1865' gas 150' O&GCM 973#
Heeb. 2962 Br Li 3076 KC 3093
DST 3094-3164 1/4 hr. gas 3" 570'
O&GCM 732# Cong. 3359 Arb. 3388
RTD 3390 5"@ 3390 WOC
- 5/21 CO DD 3401' 1/2 BOPH 2000 A
3 1/2 BOPH POP
- 5/28 NR
- 6/11 NR
- 6/18 Spud 5-2-52
Oil Well TD 3401
8" @ 245 Anhy 635
DST 2899-2920 opn 1 hr.
Rec. 1865' gas 150' o & gcm
Heeb. 2962 Br lime 3076
KC 3093 DST 3094-3164
opn 1/4 hr. gas in 3 min. Rec. 570
o & gcm Cong. 3359
Arb. 3388 TD 3390 5" @ 3390
DD 3401 1/2 boph 2000 A 3 1/2 boph
Comp. 214 bopd

COMPLETED

County Barton State Kansas

Sec. 12 (Blk. 19 (Sur. 12W Map No. 19)

Operator Aladdin & Crow

Well No. 11 Farm Kultgen (A)

Elev. _____ Location NW NE NW

330 Ft. From N Line NW

990 Ft. From E Line Quarter

1st. Report MAY 7 1952

Completion _____

Remarks _____

Crow - Contr.

Spudding Date 5-2-52

Drig. Data

8" @ 245 Anhy 635 D. lg. 1935

J. G. MCGEHEE

County Barton State KansasSec. 12 (Blk.
Twp.) 19 (Sur.
Rge.) 12W Map No.Operator Aladdin & Crowe Drlg.Well No. 11 Farm Kultgen "A"Elev. 1819 Location NW NE NW

		o			

330Ft. From N Line NW990Ft. From E Line Quarter

1st. Report

Completion JUN 1 8 1952

Remarks

Crowe Drlg. - Contr.Spudding Date 5-2-52Drlg. Data Oil well TD 34018" @ 245 Anhy 635 DST 2899-2920open 1 hr. Rec. 1865' gas 150' o & gcmHeeb. 2962 Br. lime 3076 KC 3093DST 3094-3164 open $\frac{1}{2}$ hr. gas in 3 min.Rec. 570' o & gcm Cong. 3359Arb. 3388 TD 3390 5" @ 3390DD 3401 $\frac{1}{2}$ boph 2000 A $3\frac{1}{2}$ bophComp. 214 bopd