


Section 12 Township 19 Range 12W

Well No. #2 Kultgen

Company Aladdin & Crow

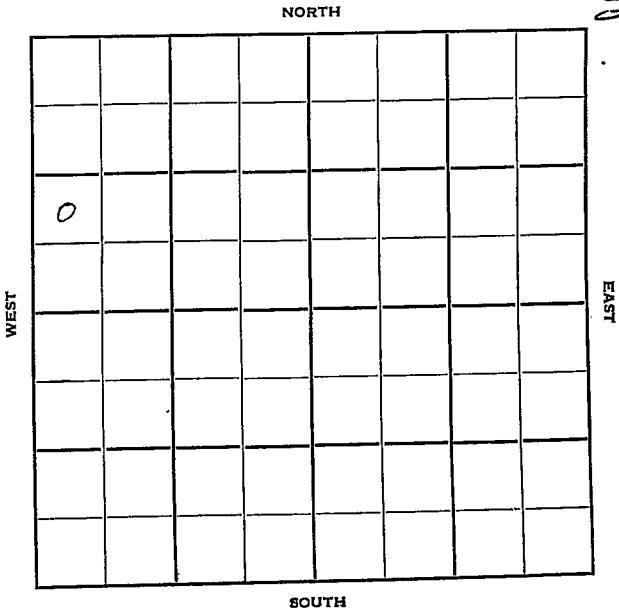

Sec. 12 Twp. 19 R. 12W

Well No. #2 Kultgen Farm

Aladdin & Crow Company

Crow Drlg. Contractor

Cheyenne View


\_\_\_\_\_ Ft. from N. Line

990' Ft. from S. Line

\_\_\_\_\_ Ft. from E. Line

330' Ft. from W. Line

NW SW NW

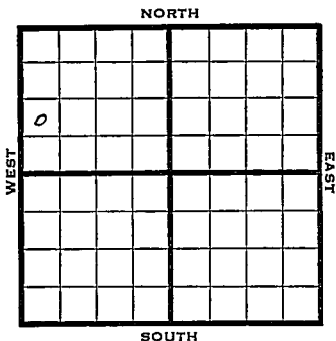

1950

Elev 1803'

REPORT

2/8

Spud 2-5-50  
8" @ 199'

3/22

8" @ 199'  
Heebner 2949'  
Br Line 3066'  
Lans 3083'  
DST 3086-3155'  
Rec gas cut mud  
Cong 3340'  
Arb. 3376'  
5" @ 3379'  
TD 3393'  
1000 acid  
Swab 6 BOPH  
No wtr.  
Comp 297 BOPD  
Comp

**COMPLETED**

Map No. \_\_\_\_\_ Sec. 12 Twp. 19 R. 12W


Well No. 2 Kultgen

Aladdin & Crow Company

Crow Drlg. Contractor

NW SW NW

SECTION PLAT

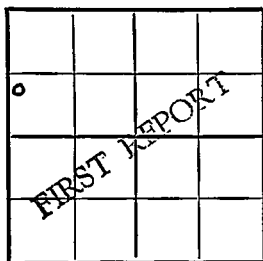

\_\_\_\_\_ Ft. from N. Line

990 Ft. from S. Line

\_\_\_\_\_ Ft. from E. Line

330 Ft. from W. Line

Barton County

Location \_\_\_\_\_

Rig up \_\_\_\_\_

Drilling and Remarks:

Spud 2-5-50

8" @ 199

RECORD

Cased \_\_\_\_\_ in., \_\_\_\_\_ ft.

Sand \_\_\_\_\_

Gas \_\_\_\_\_

Oil \_\_\_\_\_

Total Depth \_\_\_\_\_

PRODUCTION

1st 24 hrs. Nat. \_\_\_\_\_

1st 24 hrs. after shot \_\_\_\_\_

Gas \_\_\_\_\_ Cu. Ft.


Dry Hole \_\_\_\_\_

Abandoned \_\_\_\_\_

Date

FEB 8 1950 19

J. E. TYRA Scout

 

Scout Cards  
 Land Small Map  
 Land Wall Map  
 Tracings  
 France Map  
 France Map  
 Misc.

- Scout Cards
- Land Small Map
- Land Wall Map
- Tracings
- France Map
- France Map
- Misc.

10 1950

Map No. \_\_\_\_\_ Sec. 12 Twp. 19 R. 12W

Well No. 2 Kultgen

Aladdin & Crow Company

Contractor

NW SW NW

E 1.1803


SECTION PLAT

\_\_\_\_\_ Ft. from N. Line

990 Ft. from S. Line

\_\_\_\_\_ Ft. from E. Line

330 Ft. from W. Line

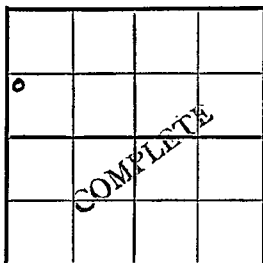

Barton County

Location \_\_\_\_\_

Rig up \_\_\_\_\_

Drilling and Remarks:

8° @ 199  
 Helner 2949  
 Br. line 3066  
 Kans. 3083  
 DST 3086-3155  
 Rec. gas cut mud  
 Cong. 3340  
 arb. 3376  
 5" c 3379  
 T. D. 3393

RECORD

Cased \_\_\_\_\_ in., \_\_\_\_\_ ft.

Sand \_\_\_\_\_

Gas \_\_\_\_\_

Oil \_\_\_\_\_

Total Depth \_\_\_\_\_

PRODUCTION

1st 24 hrs. Nat. \_\_\_\_\_

1st 24 hrs. after shot \_\_\_\_\_

Gas \_\_\_\_\_ Cu. Ft.

Dry Hole \_\_\_\_\_

Abandoned \_\_\_\_\_

Date

MAR 22 1950 19

J. E. TYRA

Scout

Scout Cards  
 Land Small Map  
 Land Wall Map  
 Tracings  
 France Map  
 Pierce Map  
 Misc.

*[Handwritten signature]*

MAR 30 1950


1000 acid  
 South 6 high  
 2978 high  
 water