


Section 12 Township 19 Range 12W

Well No. #2 Rinker "B"

Company Aladdin Petroleum

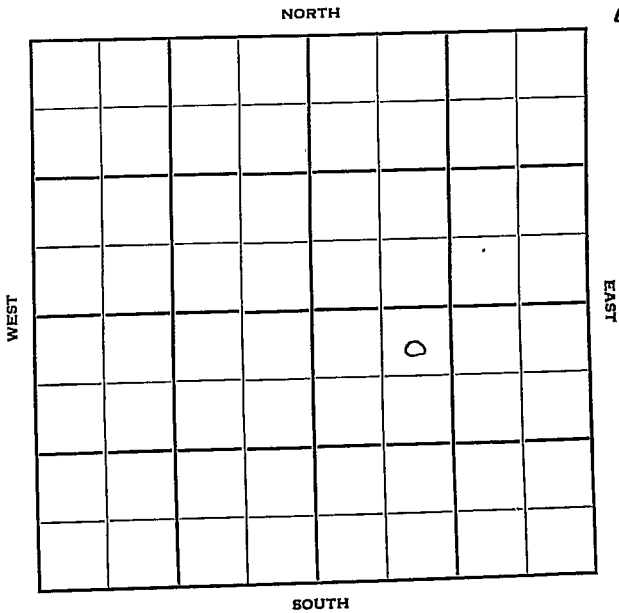

Sec. 12 Twp. 19 R. 12 WWell No. # 2 Rinker "B" FarmAladdin Petroleum Company

Contractor

Cheyenne View Pool

330

Ft. from N. Line


Ft. from S. Line

Ft. from E. Line

990

Ft. from W. Line

NE NW SE

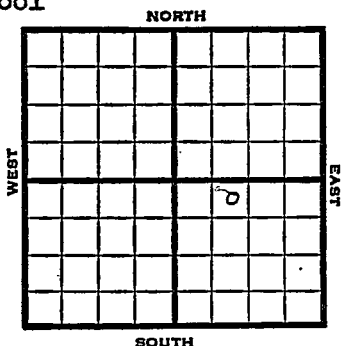

1951

Elev. 1789' REPORT

8/22

Location

9/19

Spud 8-12-51

Oil Well TD 3371

8" @ 234

Anhy 620' Br Lime 3050

KC 3068

DST 3070-3140 opn $\frac{1}{2}$ hr

Rec. 1140' ho & gcm

DST 3195-3245 opn 1 hr

Rec. 150' o & gcm

Cong. 3332 Arb. 3359-65

5" @ 3364 TD 3371

S/2 $\frac{1}{2}$ boph 1000 A S/9 boph

Comp. 245 bopd

COMPLETED

Scout Cards *mm*

AUG 27 1951

Land Small Map

Land Wall Map

Tracings


France Map

Pierce Map

Misc

Orig. Data

County Barton State Kansas
 Sec. 12 (Blk. 19) (Sur. 12W) (Twp. Map No.)
 Operator Aladdin Petroleum
 Well No. 2 Farm Rinker "B"
 Elev. 1789 Location NE NW SE

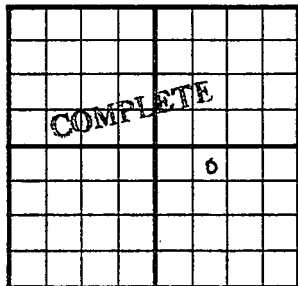

330 Ft. From N Line SE
990 Ft. From W Line Quarter
 1st. Report _____
 Completion SEP 19 1951
 Remarks Cheyenne View Pool
 Spudding Date 8-12-51

Drlg. Data Oil well TD 3371
8" @ 234 Anhy 620 Br. + lime 3050
KC 3068 DST 3070-3140 * open $\frac{1}{2}$ hr.
Rec. 1140' ho & gcm DST 3195-3245
open 1 hr. Rec. 150' o & gcm Cong. 3332
Arb. 3359-65 5" @ 3364 TD 3371 S/ $2\frac{1}{2}$
boph 1000 A S/ 9 boph
Comp. 245 bopd

Scout Cards	
Land Small Map	
Land Wall Map	
Tracings	
France Map	
Pierce Map	
Misc.	

25 1951

Drig. Data