

Section 12 Township 19 Range 12W

Well No. #1 Rinker (B)

Company Aladdin & Crowe

NORTH

10

WEST

EAST

				0			

SOUTH

Sec. 12 Twp. 19 R. 12W ✓

Well No. #1 Rinker (B) Farm \_\_\_\_\_

Aladdin & Crowe Company

Crowe - Contr. Contractor

Cheyenne View Pool


330' Ft. from N. Line

\_\_\_\_\_ Ft. from S. Line

\_\_\_\_\_ Ft. from E. Line

330' Ft. from W. Line

NW NW SE

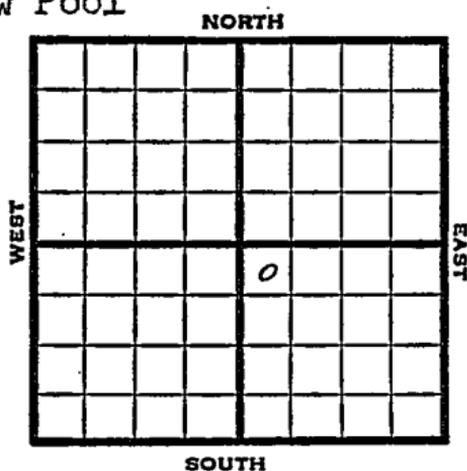

1951 Elev. 1808' REPORT

6/13 Location

8/15 Spud 6-15-51  
 Oil well TD 3388' 8" @ 235  
 Anhy 740'  
 DST 2888-2910 open 1/2 hr. rec 2600' gas  
 210' HOCM & free oil  
 Lans. 3084'  
 DST 3086-3157 open 15 min. rec 430'  
 HO & GCM  
 DST 3213-64 open 1 hr. rec 120' gas &  
 90' SO & GCM  
 Cong. 3348' Arb. 3353-48'  
 5 1/2" @ 3355 TD 3388' 500 A  
 S/1 BOPH SP 3334' 18/3321-27  
 22/3310-16 23/3302-08 24/3288-94  
 1000 A SP 3187' 32/3130-38  
 48/3100-12 36/3077-86 F/40 BOPH  
 Comp. 435 BOPD

**COMPLETED**

County Barton State Kansas

Sec. 12 (Blk. 19 (Sur. 12W Map No. (Twp.) (Rge.)

Operator Aladdin & Crowe

Well No. 1 Farm Rinker (B)

Elev. Location NW NW SE


330 Ft. From N Line SE

330 Ft. From W Line Quarter

Ist. Report JUN 13 1951

Completion

Remarks

Crowe - Contr.

Spudding Date

Drlg. Data

Location Cheyenne View Pool

J. E. TYRA

