


Section 12 Township 19 Range 12W

Well No. #3 Rinker "B"

Company Aladdin Pet. & Crowe Drlg.

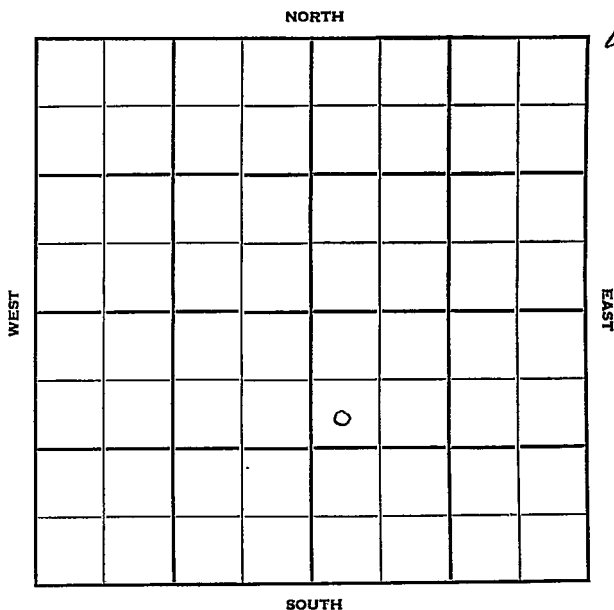

Sec. 12 Twp. 19 R. ✓

Well No. #3 Rinker "B" Farm

Aladdin Pet. & Crowe Drlg. Company

Crowe Drlg. - Contr. Contractor

Cheyenne View Pool


990' Ft. from N. Line

\_\_\_\_\_ Ft. from S. Line

\_\_\_\_\_ Ft. from E. Line

330' Ft. from W. Line

SW NW SE

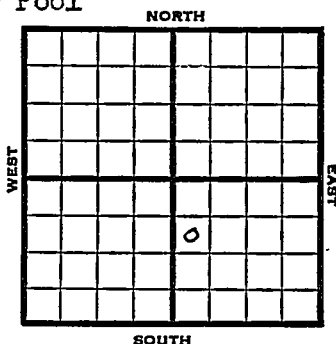

1951

REPORT

8/29 Spud 8-23-51  
8" @ 234  
Anhy 630  
Drlg. 2280'

10/17 Spud 8-23-51  
Oil Well TD 3387  
8" @ 234  
Anhy 630  
DST 2895-2911 opn 1 hr  
Rec. 290' fluid (5% oil)  
Heeb. 2952 Br Lime 3066  
KC 3083  
DST 3085-3160 opn 15 min. gas in  
8 min. Rec. 910' oil 100' wtr  
DST 3204-58 opn 20 min Rec. 150'  
o & gcm 200' hgcm 50 oil  
Arb. 3354-65 5" @ 3365  
TD 3379 1/2 boph 1000 A 1 1/2 boph  
2000 A DD 3387 4 1/2 boph 1000 A  
P/75 bo 13 hr. Comp. 205 bopd 6% wtr.

**COMPLETED**



