


Section 12 Township 19 Range 12W

Well No. #4 Rinker "B"

Company Aladdin Pet. & Crowe Drlg.

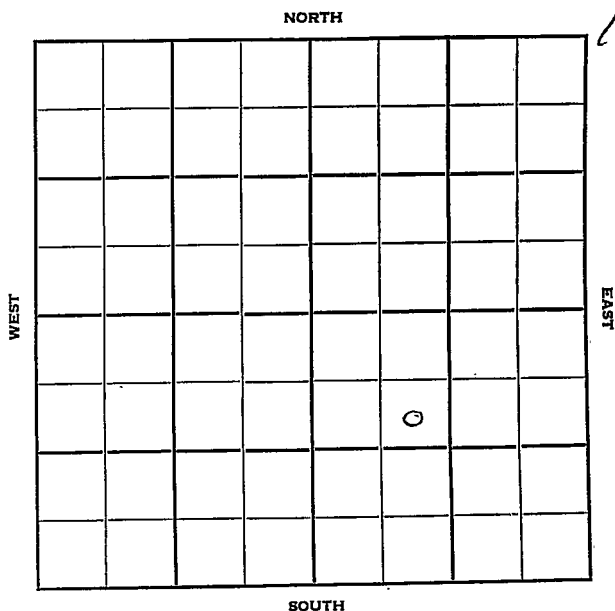

Sec. 12 Twp. 19 R. 12W

Well No. #4 Rinker "B" Farm

Aladdin Pet. & Crowe Drlg. Company

Cheyenne View Pool Contractor


990' Ft. from N. Line

_____ Ft. from S. Line

_____ Ft. from E. Line

990' Ft. from W. Line

SE NW SE

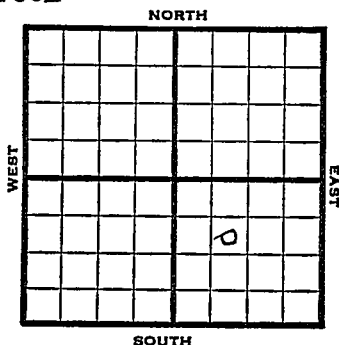

1951

Elev. 1791' REPORT

9/5
10/17

Cellar & Pits
Spud 9-6-51
Oil Well TD 3358
8" @ 243
Anhy 605' Heeb. 2935
Br Lime 3048 KC 3065
DST 3067-3135 opn 15 min.
Rec. 210' o & gcm
DST 3190-3245 opn 1 hr.
Rec. 33' mud TD 3352
5" @ 3351 Arb. 3344
DD 3358 3/4 boph 1000 A
1 boph 48/3272-82 23/3258-66
1000 A B/1 bwph PB 3239
16/3227-35 2 bwph CO to 3230
24/3214-22 24/3197-3205 1000 A
3 1/2 bwph PB 3175 24/3102-10
42/3083-97 70/3058-70
2000 A F/14 boph Comp. F/291 bopd

COMPLETED

