


Section 12 Township 19 Range 12W

Well No. #7 Louis

Company Lion Oil

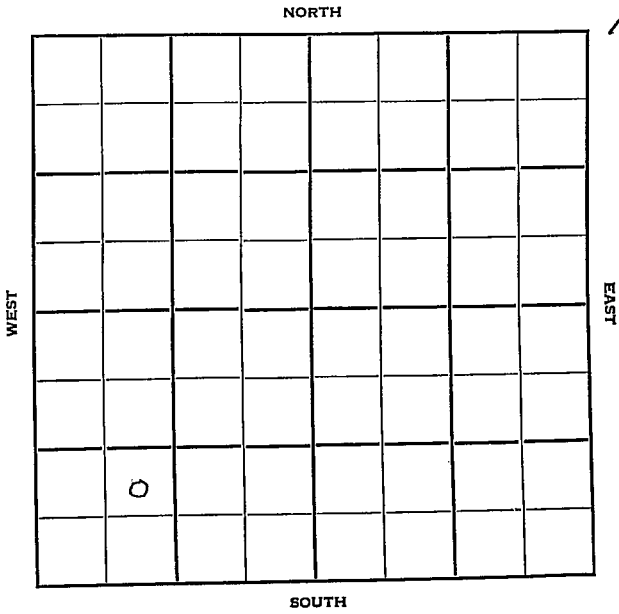

Barton

Sec. 12 Twp. 19 R. 12 W

Well No. # 7 Louis Farm

Lion Oil Company

Garvey Oil Contractor

Cheyenne View Pool


 Ft. from N. Line

990 Ft. from S. Line

 Ft. from E. Line

990 Ft. from W. Line

NE SW SW

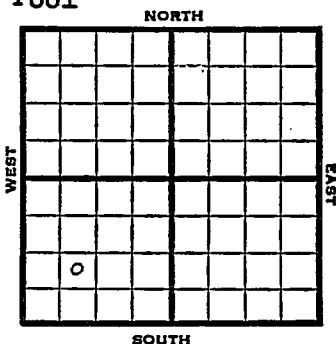

1951

Elev. 1824' REPORT

8/22

Location

10/24

Spud 8-22-51
Oil Well TD 3399
8" @ 221
Br. lm. 3089 KC 3106
DST 3110-80 open $\frac{1}{2}$ hr.
Rec. 240' SO&GCM
Cong. 3368 Arb. 3397-99
5" @ 3398 CO to 3399 S/ 3 GOPH
1500 A S/ 15 GOPH 24/ 3303-11
1000 A PB 3151 41/3128-42
37/ 3106-17 1000 A S/ 20 BO
14 BW 10 hr.
Comp. 30 BOPD 30% wtr.

COMPLETED

