


Section 12 Township 19 Range 12 W

Well No. # 5 Louis

Company Lion Oil

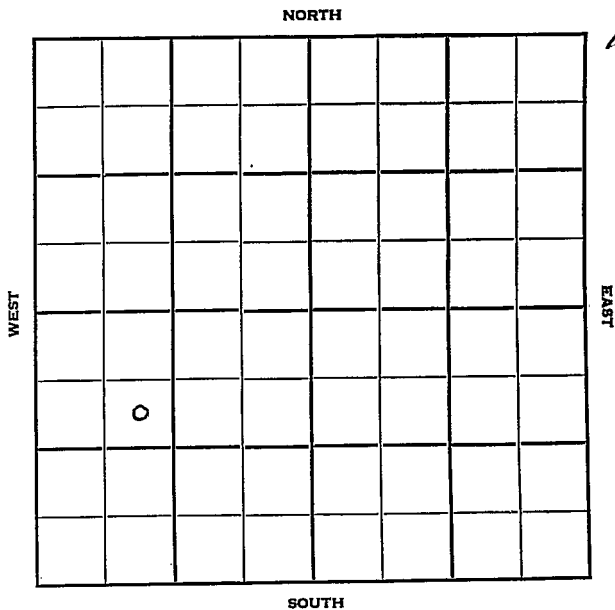

Sec. 12 Twp. 19 R. 12 W

Well No. # 5 Louis Farm

Lion Oil Company

Rine Drlg. Contractor

Cheyenne View Pool


990 Ft. from N. Line

\_\_\_\_\_ Ft. from S. Line

\_\_\_\_\_ Ft. from E. Line

990 Ft. from W. Line

SE NW SW

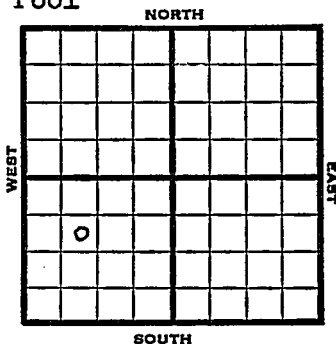

1951 Elev. 1818' REPORT

3/28 R U R

4/25 Spud 3-27-51  
 Oil Well TD 3385  
 8" @ 196  
 Heeb. 2964 Br Lime 3082  
 Lans. 3100  
 5" @ 3384 TD 3408 1000 A  
 S/water SP 3360 12/3352-56  
 12/3332-36 12/3309-17 1000 A  
 S/2 bwph SSO SP 3295  
 24/3270-78 24/3238-46 24/3182-90  
 water SP 3170 24/3142-50  
 47/3122-32 SSO 1000 A  
 S/115 bo F/30 bo 1 hr  
 Cong. 3356 ReArb 3376  
 Arb. 3383-85 TD Comp. 590 bopd

**COMPLETED**

County **Barton** State **Kansas**

Sec. **12** (Blk. Twp.) **19** (Sur. Rge.) **12W** Map No.

Operator **Lion Oil**

Well No. **5** Farm **Louis**

Elev. Location **SE NW SW**

FIRST REPORT									

**990** Ft. From **N** Line **SW**

**990** Ft. From **W** Line **Quarter**

Ist. Report **MAR 28 1951**

Completion

Remarks **Rine Drig. • Contr.**

**Cheyenne View Pool**

Spudding Date

Drig. Data

**RUR**

**J. E. TYRA**

County Barton State Kansas

Sec. 12 (Blk. 19 Twp.) (Sur. 12W Rge.) Map No.

Operator Lion Oil

Well No. 5 Farm Louis

Elev. 1818 Location SE NW SW


**COMPLETE**

990 Ft. From N Line SW

990 Ft. From W Line Quarter

Ist. Report

Completion APR 25 1951

Remarks Cheyenne View Pool

Rine Drlg. - Contr.

Spudding Date 3-27-51

Drlg. Data Oil well TD 3385

8" @ 196 Heeb. 2964 Br. lime 3082

Lans. 3100 5" @ 3384 TD 3408 1000 A

S/ water SP 3360 12/ 3352-56

12/ 3332-36 12/ 3309-17 1000 A

S/ 2 bwph SSO SP 3295 24/ 3270-78

24/ 3238-46 24/ 3182-90 Water SP 3170

24/ 3142-50 47/ 3122-32 SSO 1000 A

S/ 115 bo F/ 30 bo 1 hr. Cong. 3356

ReArb. 3376 Arb. 3383-85 TD

Comp. 590 bopd

J. E. TYRA