


Section 12 Township 19 Range 12W

Well No. #4 Louis

Company Lion Oil

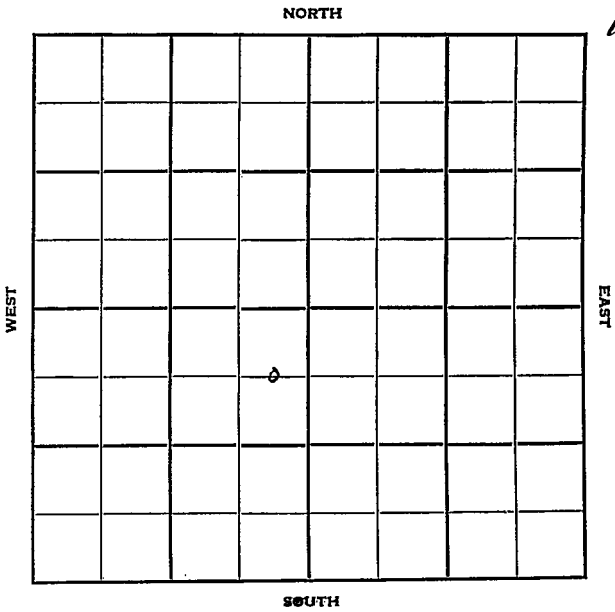

Sec. 12 Twp. 19 R. 12 W

Well No. # 4 Louis Farm

Lion Oil Company

Rine Drlg. Contractor


Cheyenne View Pool

660 Ft. from N. Line

Ft. from S. Line

330 Ft. from E. Line

Ft. from W. Line

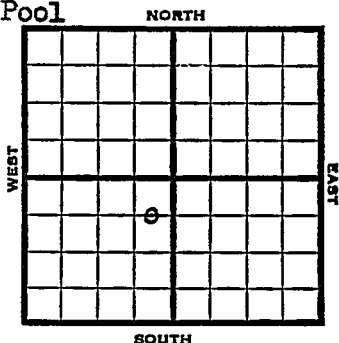

C E L N E SW

1951

Elv. 1817' REPORT

3/14

Spud 3-10-51
8" @ 206'
Drlg. 1500'

4/18

Spud 3-10-51 Oil well TD 3410'
8" @ 206 Br. line 3080' Lans 3100'
DST 3100-70 open 16 min. rec 450' oil
& mud. Cong 3372', Arb. 3407-10',
5" @ 3409', CO to 3375',
24/3292-3302 23/3266-74 22/3252-
60 21/3234-42 SP 3244' 1000 A
S/3 BOPH 7 BWPH 10 hr. SP 3180
24/3142-50 24/3122-30 24/3100-08
S/2 1/2 BOPH 2000 A F/16 BOPH
F/88 BO 8 hr.
Comp. F/264 BOPD

COMPLETED

County Barton State Kansas

Sec. 12 (Blk. 19) (Sur. 12W) (Twp.) (Rge.) Map No.

Operator Lion Oil

Well No. 4 Farm Louis

Elev. _____ Location C E L NE SW

FIRST REPORT

660 Ft. From N Line SW

330 Ft. From E Line Quarter

1st. Report MAR 14 1951

Completion _____

Remarks _____

Rine Drlg. - Contr.

Spudding Date 3-10-51

Drlg. Data Cheyenne View Pool

8" @ 206 drlg. 1500

County Barton State Kansas

Sec. 12 (Blk. 19 (Sur. 12W (Rge.) Map No.

Operator Lion Oil

Well No. 4 Farm Louis

Elev. 1817 Location C E L N E S W

COMPLETE

660 Ft. From N Line SW

330 Ft. From E Line Quarter

1st. Report

Completion APR 18 1951

Remarks Cheyenne View Pool

Rine Drlg. - Contr.

Spudding Date 3-10-51

Drlg. Data Oil well TD 3410

8" @ 206 Br. line 3080 Lans. 3100

DST 3100-70 open 16 min. Rec. 450' oil

& mud Cong. 3372 Arb. 3407-10 5" @

3409 CO to 3375 24/ 3292-3302

23/ 3266-74 22/ 3252-60 21/ 3234-42

SP 3244 1000 A S/ 3 boph 7 bwph 10 hr.

SP 3180 24/ 3142-50 24/ 3122-30

24/ 3100-08 S/ 2 1/2 boph 2000 A

F/ 16 boph F/ 88 bo 8 hr.

Comp. F/ 264 bopd