

Barton

Section 12 Township 19 Range KANSAS 12W

Well No. #2 Louis

Company Lion Oil

NORTH

12

WEST

EAST

	0						

SOUTH

Barton  
19 R.

**KANSAS**

12W

Sec. 12 Twp. \_\_\_\_\_

Well No. #2 Louis Farm \_\_\_\_\_

Lion Oil Company \_\_\_\_\_

Contractor \_\_\_\_\_

Cheyenne View Pool


330' Ft. from N. Line

NORTH

\_\_\_\_\_ Ft. from S. Line

\_\_\_\_\_ Ft. from E. Line

990' Ft. from W. Line

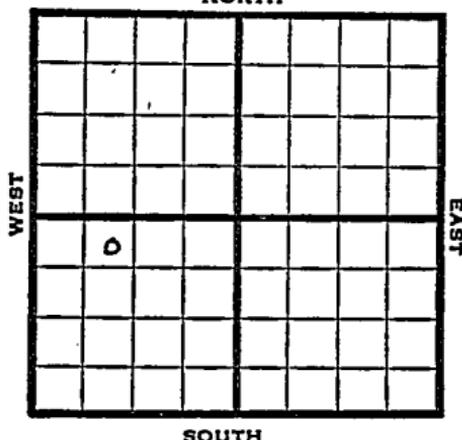

NE NW SW

1951

Elv. 1813' REPORT

1/24

Spud 1-22-51  
8" @ 193'

3/7

Spud 1-22-51  
Oil Well TD 3400  
8" @ 193  
Br Lime 3080' Lans. 3098'  
DST 3100-70 opn 7 min. gas in 5 min.  
390' ocm  
Arb. 3370-89 5" @ 3373  
TD 3389 B/8 goph  
32/3373-89 500 A B/11 goph  
DD 3400 B/1 boph 2000 A  
Comp. 96 bopd 5% wtr.

**COMPLETED**



County Barton State Kansas

Sec. 12 (Blk. 19) (Sur. 12W) (Twp. 19) (Rge. 12W) Map No.

Operator Lion Oil

Well No. 2 Farm Louis

Elev. 1813 Location NE NW SW


330 Ft. From N Line SW

990 Ft. From W Line Quarter

Ist. Report

Completion MAR 7 1951

Remarks Cheyenne View Pool

Spudding Date 1-22-51

Drlg. Data Oil well TD 3400

8" @ 193 Br. lime 3080 Lans. 3098

DST 3100-70 open 7 min. gas in 5 min.

390' ocm Arb. 3370-89 5" @ 3373

TD 3389 B/ 8 goph 32/ 3373-89 500 A

B/ 11 goph DD 3400 B/ 1 hoph 2000 A

Comp. 96 bopd 5% water

J. E. TYRA