


Section 12 Township 19 Range 12W
Well No. #1 Louis
Company Lion Oil

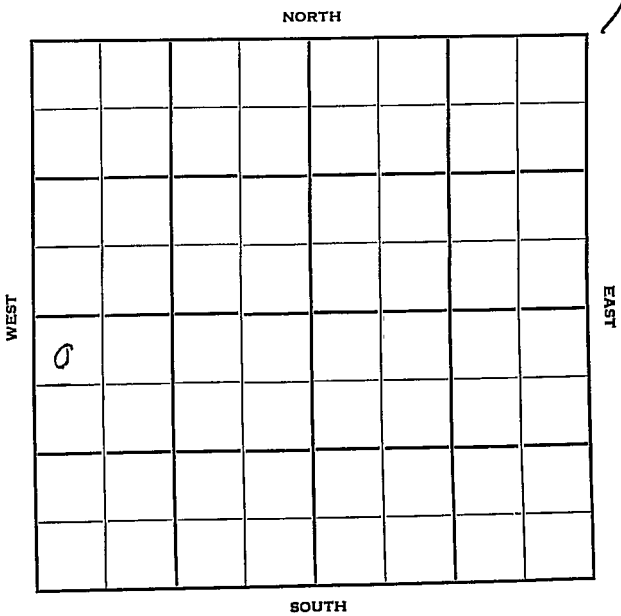

Barton

KANSAS

Sec. 12 Twp. 19 R. 12W

Well No. #1 Louis Farm

Lion Oil

Company

Cheyenne View (Rine Drlg, Contr)

330'

Ft. from N. Line


Ft. from S. Line

Ft. from E. Line

330'

Ft. from W. Line

NW NW SW

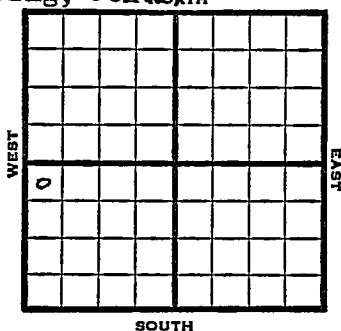

1950

Elev 1823'

REPORT

1/18

Spud 1-14-50

8" @ 265'

Drlg. 1325'

2/8

8" @ 265'

TD 3445'

5" @ 3414'

Heeb 2973'

Br L 3089'

Lans 3104'

Cong 3366'

Arb. 3414'

Plug back to 3200'

Perf 14/3152-60

1768 BOPD in Lansing

Comp

COMPLETED

Kansas

Cheyenne View

Map No. _____ Sec. 12 Twp. 19 R. 12WWell No. 1 LouisLion Oil CompanyRine Drlg. Contractor

NW NW SW

SECTION PLAT

330 Ft. from N. Line

_____ Ft. from S. Line

_____ Ft. from E. Line

330 Ft. from W. Line

0			

FIRST REPORT

Barton County

Location _____

Rig up _____

Drilling and Remarks: _____

Spud 1-14-50

8" @ 265

drlg. 1325

RECORD

Cased _____ in., _____ ft.

Sand _____

Gas _____

Oil _____

Total Depth _____

PRODUCTION

1st 24 hrs. Nat. _____

1st 24 hrs. after shot _____

Gas _____ Cu. Ft.

Dry Hole _____

Abandoned _____

Date

JAN 18 1950 19J. E. TYRA Scout

Scout Cards

Land Small Map

Land Wall Map

Tracings

France Map

Pierce Map

Misc.

JAN 20 1950

Kansas

Cheyenne View

Map No. _____ Sec. 12 Twp. 19 R. 12WWell No. 1 Louis

_____ Lion Oil _____ Company

_____ Contractor

NW NW SW

El. 1823

SECTION PLAT

330 Ft. from N. Line

_____ Ft. from S. Line

_____ Ft. from E. Line

330 Ft. from W. Line

COMPLETE			
o			

Barton County

Location _____

Rig up _____

Drilling and Remarks:

8" @ 265
 5" @ 3414
 Kub 2973
 Br L 30.89
 Lams 3104
 Cong 3366

Ans 3414 (over)
 Date _____

RECORD

Cased _____ in., _____ ft.

Sand _____

Gas _____

Oil _____

Total Depth: 3445

PRODUCTION

1st 24 hrs. Nat. _____

1st 24 hrs. after shot _____

Gas _____ Cu. Ft.

Dry Hole _____

Abandoned _____

FEB 8 1950 19

J. E. TYRA

Scout

Plug back to 3200
perf 14/3152-60

P 1768 BOPD

in Lansing

Scout Cards

Land Small Map

Land Wall Map

Tracings

France Map

Pierce Map

Misc.