


Section 12 Township 19 Range 12 W

Well No. # 1 Heinz

Company Sohie

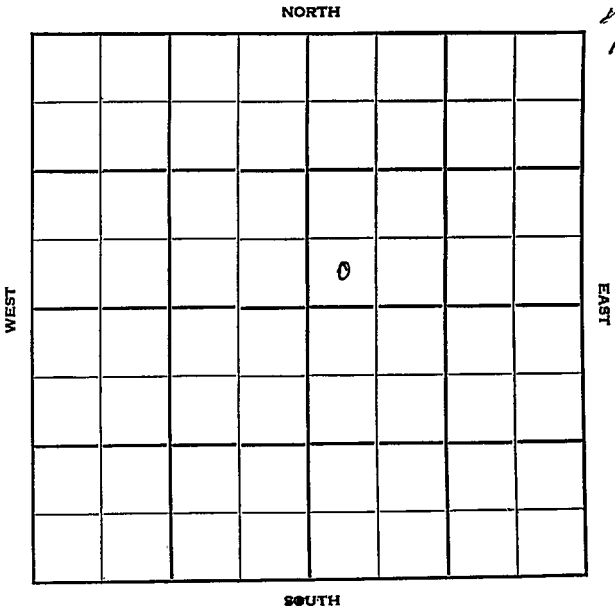

Barton

KANSAS

Sec. 12 Twp. 19 R. 12 W

Well No. # 1 Heinz Farm

Sohio Company

Cheyenne View Contractor


         Ft. from N. Line

330 Ft. from S. Line

         Ft. from E. Line

330 Ft. from W. Line

SW SW NE

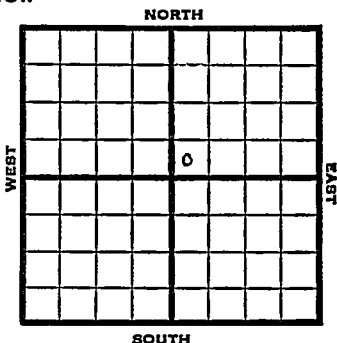

1951

Elev. 1790' REPORT

6/20 Location

8/15

Spud 7-4-51  
 Oil well TD 3382' 8" @ 317  
 Anhy 605' Heeb 2938' Br. line 3054  
 Lans. 3071'  
 DST 3073-86 open 1 hr. rec 70' HGCM  
 DST 3093-3121 open 1hr, rec 1050' free  
 oil. Arb. 3362 TD 3364'  
 5" @ 3363 Test 4 GOPH DDC3374'  
 no inc. DD 3382' B/23 GOPH 500 A  
 S/63 BO 21 hr. 1500 A S/52 BF  
 8 hr. SP 3146' 28/3116-23  
 B/ 1 pt. oil 24/3102-08 32/3092-  
 3100 44/3072-83 1/2 GO 1/2 GWP  
 2000 A F/40 BO 1/2 hr. F/72 BOPH  
 Comp. F/696 BOPD 1/2" choke

COMPLETED

County Barton State Kansas

Sec. 8-12 (Blk. Twp.) 19 (Sur. Rge.) 12W Map No.

Operator Schio

Well No. 1 Farm Heinz

Elev. Location SW SW NE

FIRST REPORT					

330 Ft. From S Line NE

330 Ft. From W Line Quarter

Ist. Report JUN 20 1951

Completion

Remarks

Spudding Date

Drlg. Data Cheyenne View

Location

~~We already show a deep dry hole  
in the Arbuckle where you report this  
location. Please check and advise~~

Sam

JUL 6 1951

~~JUL 25 1951~~

Scout Cards	ymm
Land Small Map	
Land Wall Map	3
Tracings	
France Map	
Pierce Map	
Misc.	

Drig. Data

County Barton State Kansas

Sec. 12 (Blk. 19) (Sur. Rge.) 12W Map No.

Operator Sohio

Well No. 1 Farm Heinz

Elev. 1790 Location SW SW NE

		<b>COMPLETE</b>			
		0			

330 Ft. From S Line NE

330 Ft. From W Line Quarter

1st. Report

Completion AUG 1 '5 1951

Remarks Cheyenne View Pool

Spudding Date 7-4-51

Drlg. Data Oil well TD 3382

8" @ 317 Anhy 605 Heeb. 2938

Br. lime 3054 Lans. 3071 DST 3073-86

open 1 hr. Rec. 70' hgcm DST 3093-3121

open 1 hr. Rec. 1050' free oil Arb. 3362

TD 3364 5" @ 3363 test 4 goph DD 3374

no inc. DD 3382 B/ 23 goph 500 A

S/ 63 bo 21 hr. 1500 A S/ 52 bf 8 hr.

SP 3146 28/ 3116-23 B/ 1 pt. oil

24/ 3102-08 32/ 3092-3100 44/ 3072-83

1/2 go 1/2 gwph 2000 A F/ 40 bo 1/2 hr.

F/ 72 boph Comp. F/ 696 bopd 1/2" choke

J. E. TYRA

Scout Cards *1290*

Land Small Map

Land Wall Map *35*

Tracings .....

France Map .....

Pierce map .....

Misc. ....

AUG 27 1951