

# KANSAS


FORM 51 5M PETROL

Barton

Section 12 Township 19 Range 12-W

Well No. #1 Hammeke

Company Lindas & Wenimer

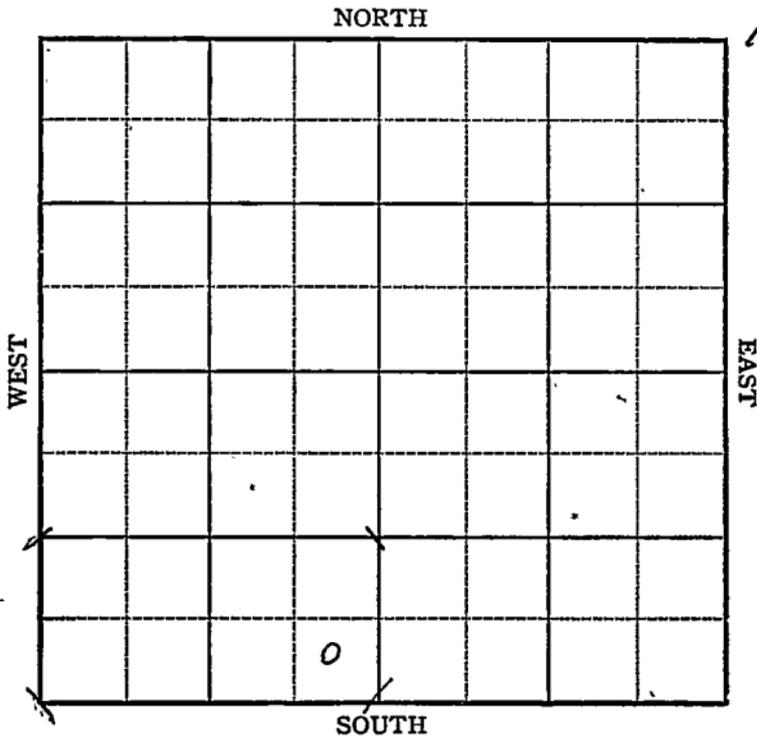


Sec. 12 Twp. 19 R. 12-W

Well No. #1 Hammeke Farm

Lindas & Wenimer Company

NORTH

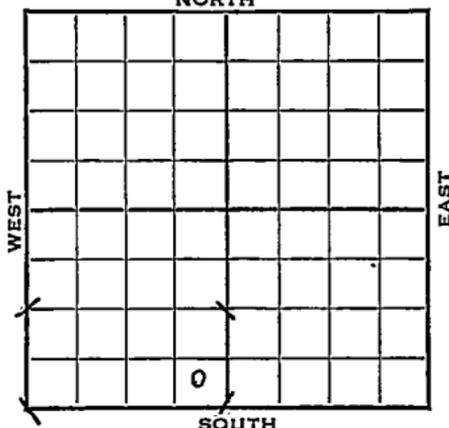

\_\_\_\_\_ Ft. from N. Line

410 Ft. from S. Line

330 Ft. from E. Line

\_\_\_\_\_ Ft. from W. Line

1943

*Elev. 1821*

REPORT

8/18

Location

8/23

Derrick

9/1

8" @ 160  
Anhy 947  
Drlg. 1411

9/8

Lans 3128  
SO 3149-51 Drlg.

9/15

Arb 3391-98 SO  
T.D. 3411 SD

9/22

T.D. 3414  
5" @ 3410'  
Rust

9/29

"

10/6

"

10/13

30 shots 3395-3402 -12200 acid

10/20

Arb 3391  
5" @ 3410'  
Water  
T.D. 3438'

**ABANDONED**

KANSAS

Map No. 46 Sec. 12 Twp. 19 R. 12W

Well No. 1 Hammeke

Lindas & Wenimer Company

FIRST REPORT Contractor

SE SW

SECTION PLAT

           Ft. from N. Line

410 Ft. from S. Line

330 Ft. from E. Line

           Ft. from W. Line


WILDCA T

Location X

Rig up           

Drilling and Remarks:           

RECORD

Cased            in.,            ft.

Sand           

Gas           

Oil           

Total Depth           

PRODUCTION

1st 24 hrs. Nat.           

1st 24 hrs. after shot           

Gas            Cu. Ft.


Dry Hole           

Abandoned           

Date

AUG 1. 8 1943 19

S. J. LEWIS Scout

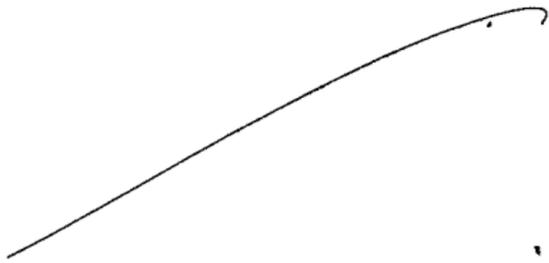

Misc Small Maps	<i>Onya</i>
Cards	<i>Back</i>
Tracing	<i>ONE 2</i>
France Map	<i>[initials]</i>
Scarborough Map	<i>[initials]</i>
Moody Map	<i>ONE 2</i>
Geological Dept.	
Moody Flat Book	

Map No. KAN 26 Sec. 12 Twp. 19 R. 12W

Well No. 1 Hammeke

Lindas & Wenimer Company

**ABANDONED**

Contractor

SE SW


SECTION PLAT

\_\_\_\_\_ Ft. from N. Line

410 Ft. from S. Line

330 Ft. from E. Line

\_\_\_\_\_ Ft. from W. Line

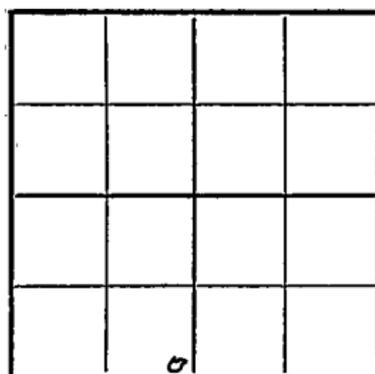

Wildcat

Location \_\_\_\_\_

Rig up \_\_\_\_\_

Drilling and Remarks:

*Cor 8391*  
*5 103410*  
*Water*

RECORD

Cased \_\_\_\_\_ in., \_\_\_\_\_ ft.

Sand \_\_\_\_\_

Gas \_\_\_\_\_

Oil \_\_\_\_\_

Total Depth 3438

PRODUCTION

1st 24 hrs. Nat. \_\_\_\_\_

1st 24 hrs. after shot \_\_\_\_\_

Gas \_\_\_\_\_ Cu. Ft.


✓ Dry Hole \_\_\_\_\_

Abandoned \_\_\_\_\_

Date

OCT 20 1943 19

S. J. LEWIS Scout

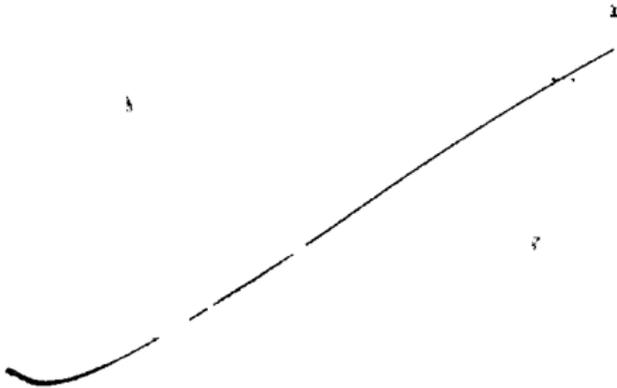

Misc Small Maps	<i>ma</i>
Cards	<i>ma</i>
Tracing	<i>ma</i>
France Map	<i>ma</i>
Scarborough Map	<i>ma</i>
Pierce Map	<i>ma</i>
Geological Dept.	
Pierce Flat Desk	