


Section 12 Township 19 Range 11W

Well No. #1 Koett

Company Sauvage & Dunne

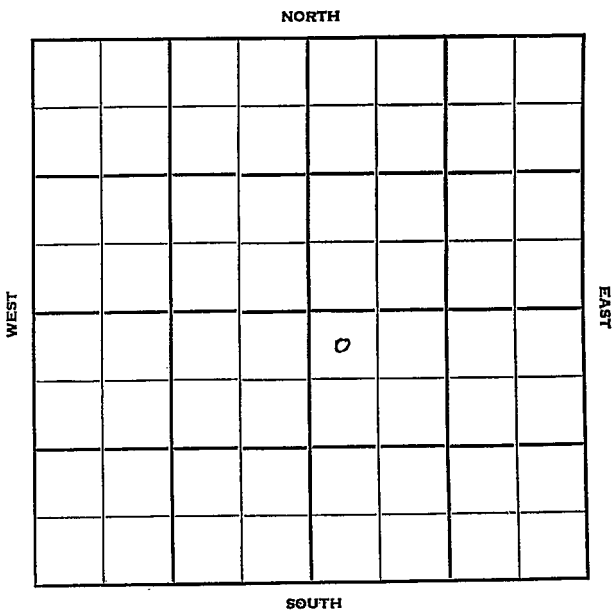

Barton

KANSAS

Sec. 12 Twp. 19 R. 11W

Well No. #1 Koett Farm

Sauvage & Dunne Company

Sauvage & Dunne - Contr. Contractor


330' Ft. from N. Line

 Ft. from S. Line

 Ft. from E. Line

330' Ft. from W. Line

NW NW SE

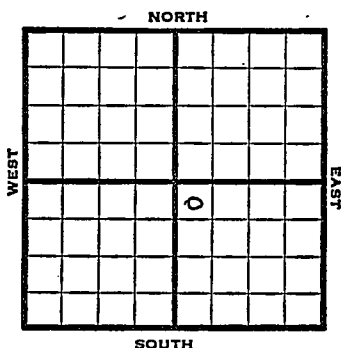

1951 Elev. 1776' REPORT

11/21 Spud 11-13-51
8" @ 190
Anhy 860
Drlg. 3019

1952
2/6 TD 3350'
5" @ 3349' POP

2/13 No report


2/20 "

3/5 NR

3/12 Spud 11-13-51
Oil Well TD 3354
8" @ 190
Anhy 860 Heeb. 2898
Br Lime 3016 Lans. 3035
Arb. 3347-50 5" @ 3349
DD 3354 500 A S/3 boph
Comp. 25 bopd

COMPLETED

County Barton State Kansas
 Sec. 12 (Blk.) 19 (Sur. Rge.) 11W Map No.
 Operator Sauvage & Dunne
 Well No. 1 Farm Koett
 Elev. _____ Location NW NW SE

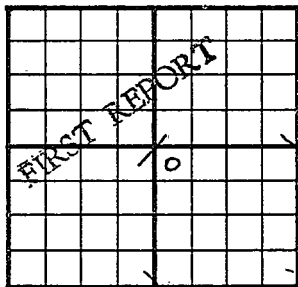

330 Ft. From N Line SE

330 Ft. From W Line Quarter

Ist. Report NOV 21 1951

Completion _____

Remarks _____

Sauvage & Dunne - Contr.


Spudding Date 11-13-51

Drlg. Data _____

8" @ 190 Anhy 860 drlg. 3019

J. E. TYRA

County Barton State _____
 Sec. 12 (Blk. 19 (Sur. 11W Map No. _____
 (Twp.) (Rge.)
 Operator Sauvage & Dunne
 Well No. 1 Farm Koett
 Elev. 1776 Location NW NW SE

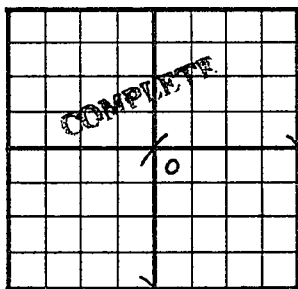

330 Ft. From N Line SE
330 Ft. From W Line Quarter
 Ist. Report _____
 Completion MAR 1 2 1952
 Remarks Rick Pool
Sauvage & Dunne - Contr.
 Spudding Date 11-13-51

Drlg. Data Oil well TD 3354
8" @ 190 Anhy 860 Heeb. 2898
Br. lime 3016 Lans. 3035 Arb. 3347-50
5" @ 3349 DD 3354 500 A S/ 3 boph
Comp. 25 bopd