

KANSAS

Barton

FORM 51 IOM 12-46 PETROL

Section 12 Township 19 Range 11-W

Well No. 1 Rader #A

Company C. E. Ash

Rick Pool

NORTH

		o					
		1					

WEST

EAST

SOUTH

KANSAS

Barton

Sec. 12 Twp. 19 R. 11W

Well No. #1 Rader "A" Farm

C. E. Ash Company


990 Ft. from N. Line

 Ft. from S. Line

990 Ft. from E. Line

 Ft. from W. Line

SW NE NW

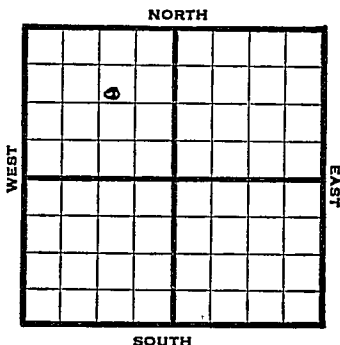

1947

REPORT

10/8	RUR
10/15	8" @ 184' Drlg. 1360'
10/22	Drlg. 3205'
10/29	Lansing 3044' Arbuckle 3370' TD 3387' SO 5" @ 3376' RUST
11/5	"
11/12	"
11/19	"
11/25	"
12/3	TD 3387' 1000' oil & 100' W in 48 hrs.
12/10	"
12/17	"
12/30	1000 acid No help TD 3391' 200' W PH PB 3382
1948 1/7	"

OVER

1948

1/14 1000 acid
Nowell 3391'
200 W PH PB 3382'

1/21 PB 3387' swb 30 bbls oil / 30 W
24 hrs

1/26 "

2/4 "

2/11 "

2/18 "

2/25 "

3/3 Arbuckle 3370'
5" @ 3376'
1,000 Acid
Pump 50 oil / 50 W Pot.
Total Depth 3391'
Gr. 400

COMPLETED

Map No. _____ Sec. 12 Twp. 19 R. 11W

Well No. 1 Rader "A"

C. E. Ash _____ Company

FIRST REPORT _____ Contractor

SW NE NW

SECTION PLAT

990 Ft. from N. Line

_____ Ft. from S. Line

990 Ft. from E. Line

_____ Ft. from W. Line

	D		

Barton County

Location _____

Rig up _____

Drilling and Remarks:

R U R

RECORD

Cased _____ in., _____ ft.

Sand _____

Gas _____

Oil _____

Total Depth _____

PRODUCTION

1st 24 hrs. Nat. _____

1st 24 hrs. after shot _____

Gas _____ Cu. Ft.

Dry Hole _____

Abandoned _____

Date

OCT 8 1947 19

S. J. LEWIS

Scout

Handwritten scribble

Misc. Small Maps	<i>[initials]</i>
Cards	<i>Ruth</i>
Tracing	<i>[initials]</i>
For	
Col	
Flora	

Map No. 46 Sec. 12 Twp. 19 R. 11W

Well No. 1 Rader "A"

C. E. Ash Company

COMPLETE

Contractor

SW NE NW

21, 1976
SECTION PLAT

990 Ft. from N. Line

_____ Ft. from S. Line

990 Ft. from E. Line

_____ Ft. from W. Line

	0		

Barton County

Location _____

Rig up _____

Drilling and Remarks:

1,000 acid
Pump 50 oil 150W
BJ
HO 2 1/2"

RECORD

Cased _____ in., _____ ft.

Sand _____

Gas _____

Oil _____


PRODUCTION

1st 24 hrs. Nat. _____

1st 24 hrs. after shot _____

Gas _____ Cu. Ft.

Dry Hole _____

Abandoned _____

Date

MAR 3 1948 19

S. J. LEWIS

Scout

