

KAPCIS

Barton

Section 12 Township 19 Range 11WWell No. 2 JohanningCompany Vickers

Rick

NORTH

				0			

WEST

EAST

SOUTH

KANSAS

Barton

Sec. 12 Twp. 19 R. 11W ✓

Well No. #2 Johanning Farm

Vickers

Company

Rick Pool


 Ft. from N. Line

330' Ft. from S. Line

 Ft. from E. Line

330' Ft. from W. Line

SW NE

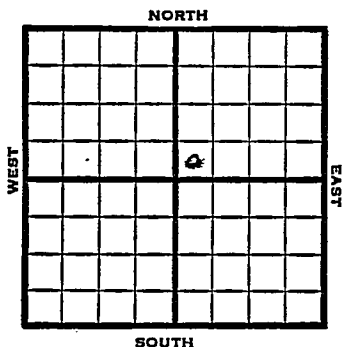

1949

Elev 1776' REPORT

4/20

8" @ 203'

Drlg. 600'

4/27

Drlg 2315'

5/4

Lansing 3036'

Arb. 3366

5"@ 3367

TD 3373'

1000 acid

Swb 7 bbls oil PH 4 hrs.

5/10

5/18

TD 3373'

Arb. 3366'

5"@ 3367'

1000 acid

Pump 100 oil Pot

40° Gr.

Comp

COMPLETED

Map No. _____ Sec. 12 Twp. 19 R. 11W

Well No. 2 Johanning

Vickers Company

FIRST REPORT Contractor

SW NE

SECTION PLAT

_____ Ft. from N. Line

330 Ft. from S. Line

_____ Ft. from E. Line

330 Ft. from W. Line

Barton County

Location _____

Rig up _____

Drilling and Remarks:

8" @ 203

dr lg. 600

RECORD

Cased _____ in., _____ ft.

Sand _____

Gas _____

Oil _____

Total Depth _____

PRODUCTION

1st 24 hrs. Nat. _____

1st 24 hrs. after shot _____

Gas _____ Cu. Ft.

Dry Hole _____

Abandoned _____

Date

APR 20 1949 19

S. J. LEWIS

Scout

Kansas

Map No. K46 Sec. 12 Twp. 19 R. 11WWell No. 2 Johanning


Vickers

Company

COMPLETE

Contractor

SW NE

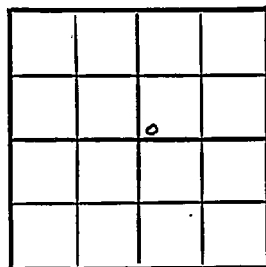E11774
SECTION PLAT

Ft. from N. Line

330

Ft. from S. Line

Ft. from E. Line

330

Ft. from W. Line

Barton County

Location

Rig up

Drilling and Remarks:

Per 33665" C 33671000 acidPump 100 ibl Per 336740 1/2 lb

RECORD

Cased _____ in., _____ ft.

Sand _____

Gas _____

Oil _____

Total Depth 2328

PRODUCTION

1st 24 hrs. Nat. _____

1st 24 hrs. after shot _____

Gas _____ Cu. Ft.

Dry Hole _____

Abandoned _____

Date

MAY 18 1949

19

S. J. LEWIS

Scout