
FORM 51 5M BRIX

KANSAS

Section 12 Township 19 Range 11W

Well No. 1 Koetle

Company Vickers

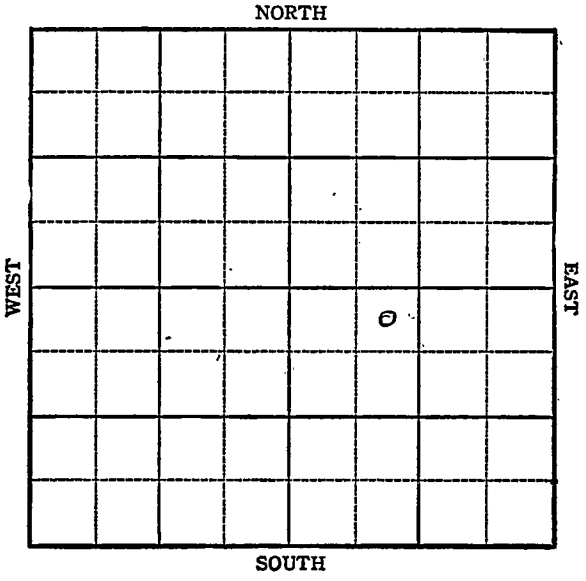

KANSAS

FORM 252-A
5M 3-44 PETROL

Barton

Sec. 12 Twp. 19 R. 11W

Well No. #1 Knetle Farm

Vickers Company


Karber

330 Ft. from N. Line

_____ Ft. from S. Line

_____ Ft. from E. Line

990 Ft. from W. Line

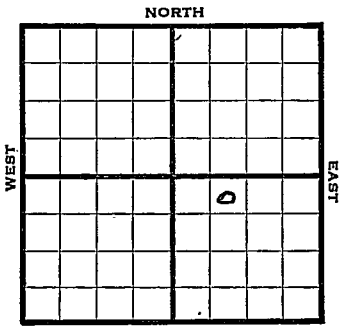

Elev 1775

NE NW SE

1944	REPORT
8/30	Loc.
9/8	Drk.
9/13	10" @ 205 Drlg. 2020
9/21	Heebner 2916 Lans 3041 Arb 3344 TD 3347 5" @ 3345 RUST
9/28	TD 3359 2000 acid 300' oil
10/4	Arb 3344 5" @ 3345 TD 3362
	ABANDONED

FORM 26 200 BKS. 2-44 PETROL

KANSAS

Pool Name Karber

Map No. 46 Sec. 12 Twp. 19 R. 11W


Well No. 1 Koetle

Vickers Company

FIRST REPORT Contractor

NE NW SE

SECTION PLAT

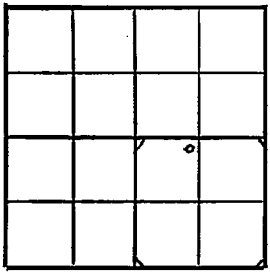

330 Ft. from N. Line

Ft. from S. Line

Ft. from E. Line

990 Ft. from W. Line

Barton County

Location X

Rig up

Drilling and Remarks:

RECORD

Cased in., ft.

Sand

Gas

Oil

Total Depth

PRODUCTION

1st 24 hrs. Nat.

1st 24 hrs. after shot

Gas Cu. Ft.

Dry Hole

Abandoned

Date

AUG 30 1944 19

S. J. LEWIS Scout

FORM 56 200 BKS. 1-44 PETROL

Pool Name Karber

Map No. 46 Sec. 12 Twp. 19 R. 11W


Well No. 1 Koette

Vickers Company

ABANDONED Contractor

NE NW SE

SECTION PLAT

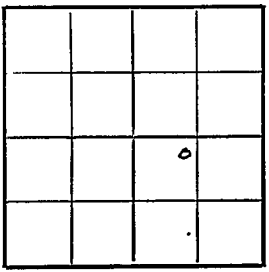

330 Ft. from N. Line

Ft. from S. Line

Ft. from E. Line

990 Ft. from W. Line

Barton County

Location

Rig up

Drilling and Remarks:

Cu @3344

5" @3345

RECORD

Cased in. ft.

Sand

Gas

Oil

Total Depth 3362

PRODUCTION

1st 24 hrs. Nat.

1st 24 hrs. after shot

Gas Cu. Ft.

Dry Hole

Abandoned

Date

OCT 4 1944 19

S. J. LEWIS Scout