

KANSAS


Barton

FORM 51 5M 10-41 PETROL

Section 12 Township 19 Range 11 W

Well No. #2 Rick

Company Max Cohn etal.

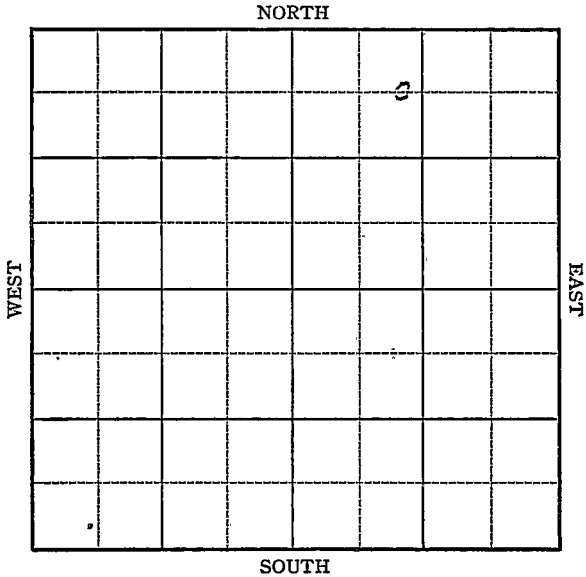

KANSAS

Barton

Sec. 12 Twp. 19 R. 11-W

Well No. #2. Rick Farm

Max Cohen etal. Company


Rick Pool

660 Ft. from N. Line

_____ Ft. from S. Line

_____ Ft. from E. Line

990 Ft. from W. Line

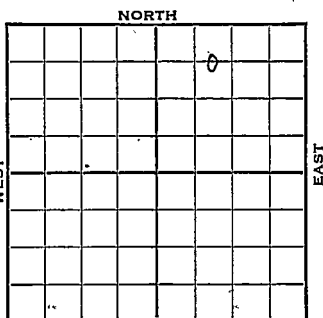

C EL NW NE 1774 DF 1772 Gr (Est)

1942

REPORT

12/16 8" * 170'

Drig. 2194'

12/22 Lans 3039

Drig. 3125'

12/29 Topeka 2647 Lans. 3036

Corrected Arb. 3345-53 TD

5" - 3345 RUST

1943

1/6 T. D. 3356

1 bailer of oil 2 1/2 hrs.

1/13 T.D. 3362'

2100 gals. acid swab 6l bbls oil

Temp. Pot.

1/20 " " " " " "

1/27 " "

2/3 " " "

2/10 Arb. 3345

5" @ 3345'

T.D. 3362'

2100 gal acid

Pump 325 pot.

Gravity 35

COMPLETED

KANSAS

Barton

Map No. 46 Sec. 12 Twp. 19 R. 11WWell No. 2 RickMax Cohen et al. Company**FIRST REPORT** Contractor

C E L N W N E

SECTION PLAT

660 Ft. from N. Line

_____ Ft. from S. Line

_____ Ft. from E. Line

990 Ft. from W. Line

RICK POOL

Location _____

Rig up _____

Drilling and Remarks:

8" - 170'

Drlg. 2194'

RECORD

Cased _____ in., _____ ft.

Sand _____

Gas _____

Oil _____

Total Depth _____

PRODUCTION

1st 24 hrs. Nat. _____

1st 24 hrs. after shot _____

Gas _____ Cu. Ft.

Dry Hole: _____

Abandoned _____

Date

DEC 16 1942 19

S. J. LEWIS Scout

Barton

Map No. 46 Sec. 12 Twp. 19 KANSAS
R. 11WWell No. 2 RickMax Cohen et al. CompanyCOMPLETED Contractor

C EL NW NE

SECTION PLAT

660 Ft. from N. Line

_____ Ft. from S. Line

_____ Ft. from E. Line

990 Ft. from W. Line

		0	

RICK POOL

Location _____

Rig up _____

Drilling and Remarks:

Per 8345
5" @ 3345
2100 Acid
Pump 825 Per

35° Sw

RECORD

Cased _____ in., _____ ft.

Sand _____

Gas _____

Oil _____

Total Depth 3362

PRODUCTION

1st 24 hrs. Nat. _____

1st 24 hrs. after shot _____

Gas _____ Cu. Ft.

Dry Hole _____

Abandoned _____

Date

FEB 10 1943 19

S. J. LEWIS Scout