
KANSAS
FORM 31 5M 1-42 PETROL

Barton

Section 12 Township 19 Range 11W

Well No. #1 Wood

Company Vickers

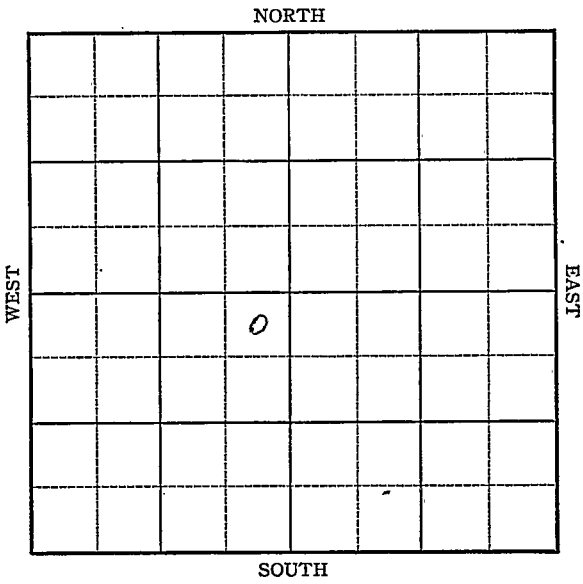

KANSAS

FORM 252-A
5M 3-44 PETROL

Barton

Sec. 12 Twp. 19 R. 11W

Well No. #1 Wood Farm

Vickers Company

Rick


330 Ft. from N. Line

Ft. from S. Line

330 Ft. from E. Line

Ft. from W. Line

Elev. 1776

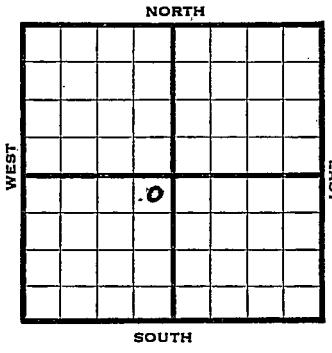

1944	REPORT
7/19	10" @ 181 Drilling 1145
7/26	Lans. 3035 Drlg. 3240
8/2	Cong. 3327 Arb 3351 5" @ 3352 TD 3369 1500' oil swb 5 oil per hr 12 hrs.
8/9	" " " " " " " " " " " "
8/16	" " " " " " " " " " " "
8/23	" " " " " " " " " " " "
8/30	" " " " " " " " " " " "
9/8	" N" " " " " " " " " "
9/13	" " " " " " " " " " " "
9/20	Arb 3351 5" @ 3352 1000 acid Pump 227 pot. TD 3369 Grav. 40

COMPLETED

FORM 26 200 BKS 2-44 PETROL

KANSAS

Pool Name Rick

Map No. 96 Sec. 12 Twp. 19 R. 11W


Well No. 1 Wood

Vickers Company

FIRST REPORT Contractor

NE SW

SECTION PLAT

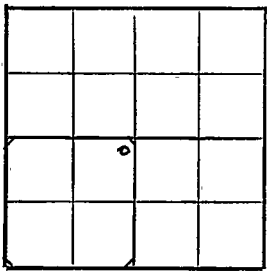

330 Ft. from N. Line

Ft. from S. Line

330 Ft. from E. Line

Ft. from W. Line

Barton County

Location

Rig up

Drilling and Remarks:

10" - 181

1145

RECORD

Cased in., ft.

Sand

Gas

Oil

Total Depth

PRODUCTION

1st 24 hrs. Nat.

1st 24 hrs. after shot

Gas Cu. Ft.

Dry Hole

Abandoned

Date

JUL 1 9 1944 19 S. J. LEWIS Scout

FORM 26 200 BKS 1-44 PETROL

KANSAS

Pool Name Karber Pool

Map No. 46 Sec. 12 Twp. 19 R. 11W

Well No. 1 Wood

Vickers Company

COMPLETED Contractor

NE SW

330 Ft. from N. Line


Ft. from S. Line

330 Ft. from E. Line

Ft. from W. Line

Barton County

SECTION PLAT

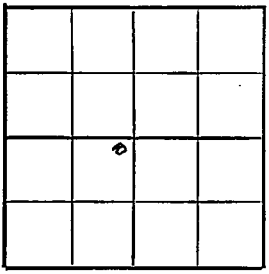

Location

Rig up

Drilling and Remarks:

Cer Y3351

5"@3352

1000 acid

Pump 227 Bbl

40 ° Gr

RECORD

Cased in., ft.

Sand

Gas

Oil

Total Depth 3346

PRODUCTION

1st 24 hrs. Nat.

1st 24 hrs. after shot

Gas Cu. Ft.

Dry Hole

Abandoned

Date

SEP 20 1944 19

S. J. LEWIS Scout