


Section 12 Township 19 Range 11-W

Well No. #3 Wood

Company Vickers Pet.
Rick Pool

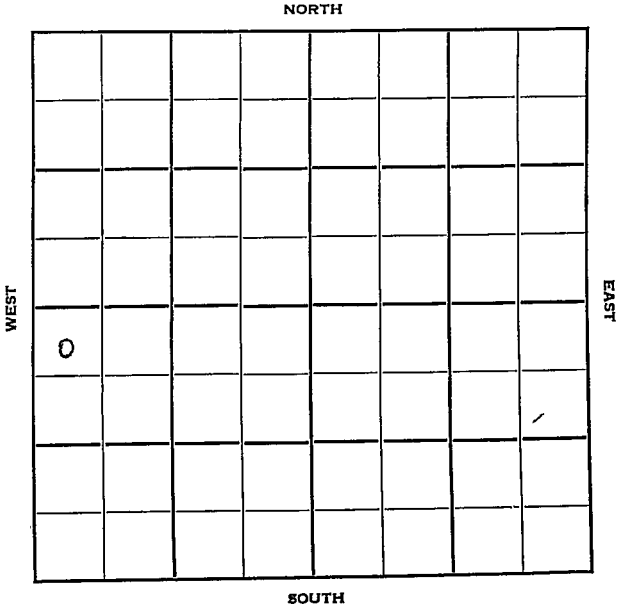

Barton KANSAS

Sec. 12 Twp. 19 R. 11W ✓

Well No. #3-- Wood Farm

Vickers Pet. Company

Rick Pool Contractor


330' Ft. from N. Line

 Ft. from S. Line

 Ft. from E. Line

330' Ft. from W. Line

NW NW SW

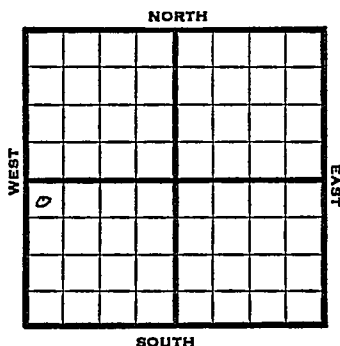

1950 Elev 1786' REPORT

3/1 Spud 2-27-50
Drlg.

4/5 TD 3776'
8" @ 200
5" @ 3346'
Heeb 2912'
Lans 3047'
Arb. 3346'
40 BOPD
20% wtr.
Comp

COMPLETED

Kansas

Rick Pool

Map No. _____ Sec. 12 Twp. 19 R. 11WWell No. 3 Wood

Vickers Pet. _____ Company _____

Contractor _____

NW NW SW

SECTION PLAT

o			

FIRST REPORT330 Ft. from N. Line

_____ Ft. from S. Line

_____ Ft. from E. Line

330 Ft. from W. Line

Barton County

Location _____

Rig up _____

Drilling and Remarks:

Spud 2-27-50

drlg.

RECORD

Cased _____ in., _____ ft.

Sand _____

Gas _____

Oil _____

Total Depth _____

PRODUCTION

1st 24 hrs. Nat. _____

1st 24 hrs. after shot _____

Gas _____ Cu. Ft.

Dry Hole _____

Abandoned _____

Date _____

J. E. TYRAMAR 1 1950

Scout

Map No. _____ Sec. 12 Twp. 19 R. 11^WWell No. 3 Wood

_____ Vickers Pet. _____ Company

_____ Contractor

NW NW SW


E. 1786

SECTION PLAT

330 Ft. from N. Line

_____ Ft. from S. Line

_____ Ft. from E. Line

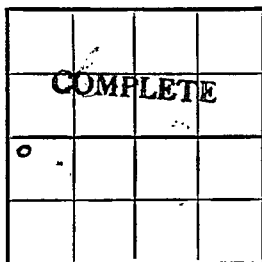330 Ft. from W. Line

Barton County

Location _____

Rig up _____

Drilling and Remarks:

*8' @ 200**5' @ 3346**Keel 2912**Lens 3047**ant 3346**40 BOPD**2670 water*

RECORD

Cased _____ in., _____ ft.

Sand _____

Gas _____

Oil _____

Total Depth 3776

PRODUCTION

1st 24 hrs. Nat. _____

1st 24 hrs. after shot _____

Gas _____ Cu. Ft.

Dry Hole _____

Abandoned _____

Date

APR 5 1950

19

J. E. TYRA Scout