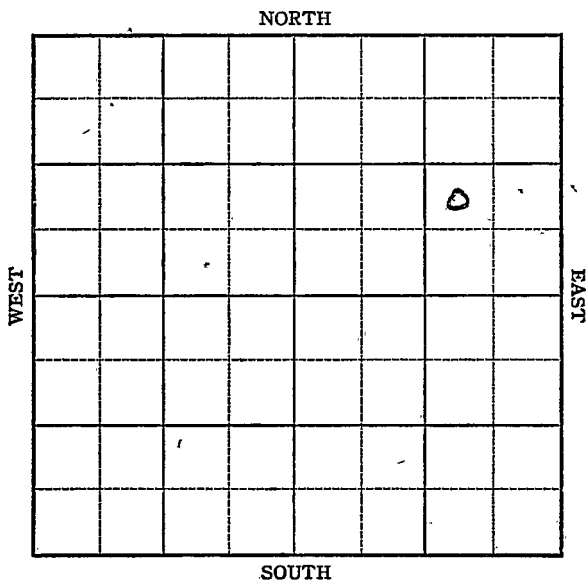


FORM 51 IOM 12-46 PETROL

KANSAS

Section 12 Township 19 Range 10WWell No. 1 Flora "A"Company Keys Drlg Co.

Rice

KANSAS

Sec. 12 Twp. 39 R. 10 W

Well No. #1 Flora "A" Farm

Keyes Drlg. Company

Silica Pool

p


 Ft. from N. Line

990 Ft. from S. Line

990 Ft. from E. Line

 Ft. from W. Line

NW SE NE

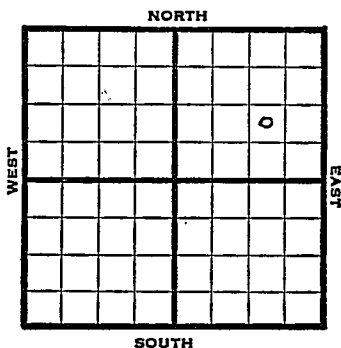

1947

Elev. 1721'

REPORT

6/18

R U R

6/24

Drlg 2740'

7/1

Arbucke 3285'
5" @ 3258'
TD 3267'
750' oil in 6 hrs.

7/8

" "

7/16

TD 3267'

7/22

"

7/29

TD 3279'

8/6

"

8/13

"

8/20

"

8/27

"

9/3

"

9/10

"

9/17

"

9/24

"

OVER

1947

10/1 Arbuckle 3258
 5" @ 3258
 TD 3279

ABANDONED

Map No. _____ Sec. 12 Twp. 19 R. 10W

Well No. 1 Flora "A"


Keyes Drlg. Company

FIRST REPORT

Contractor

NW SE NE

SECTION PLAT

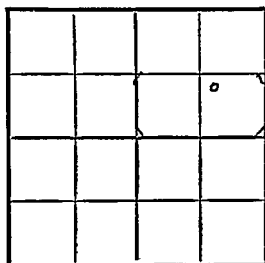

_____ Ft. from N. Line

990 Ft. from S. Line

990 Ft. from E. Line

_____ Ft. from W. Line

Rice County

Location _____

Rig up _____

Drilling and Remarks:

R U R

RECORD

Cased _____ in., _____ ft.

Sand _____

Gas _____

Oil _____

Total Depth _____

PRODUCTION

1st 24 hrs. Nat. _____

1st 24 hrs. after shot _____

Gas _____ Cu. Ft.

Dry Hole _____

Abandoned _____

Date

JUN 18 1947 19

S. J. LEWIS Scout

Misc. Small Maps

Cards

Tracing

France Map

Scarborough Map

Pierce Map

Geological Dept.

Pierce Plot Book

Map No. 46 Sec. 12 Twp. 19 R. 10W

Well No. 1 Flora "A"

Keyes Drlg. Company
ABANDONED

Contractor

NW SE NE

E11721
SECTION PLAT

_____ Ft. from N. Line

990 Ft. from S. Line

990 Ft. from E. Line

_____ Ft. from W. Line

Rice County

Location _____

Rig up _____

Drilling and Remarks:

*Per 8258
5108258*

RECORD

Cased _____ in., _____ ft.

Sand _____

Gas _____

Oil _____

Total Depth 8279

PRODUCTION

1st 24 hrs. Nat. _____

1st 24 hrs. after shot _____

Gas _____ Cu. Ft.

Dry Hole _____

Abandoned _____

Date

OCT 1 1947

19

S. J. LEWIS

Scout

194

Wm

Misc. C. & L.
Cards *E. L. L.*
Tracing *E. L. L.*
France (E. L.)
Scarborough Map *E. L. L.*
Pierce Map *E. L. L.*
Geological E.
Pierce Flat Port