


Section 12 Township 19 Range 10- W

Well No. #3 Flora

Company Keyes Drlg.

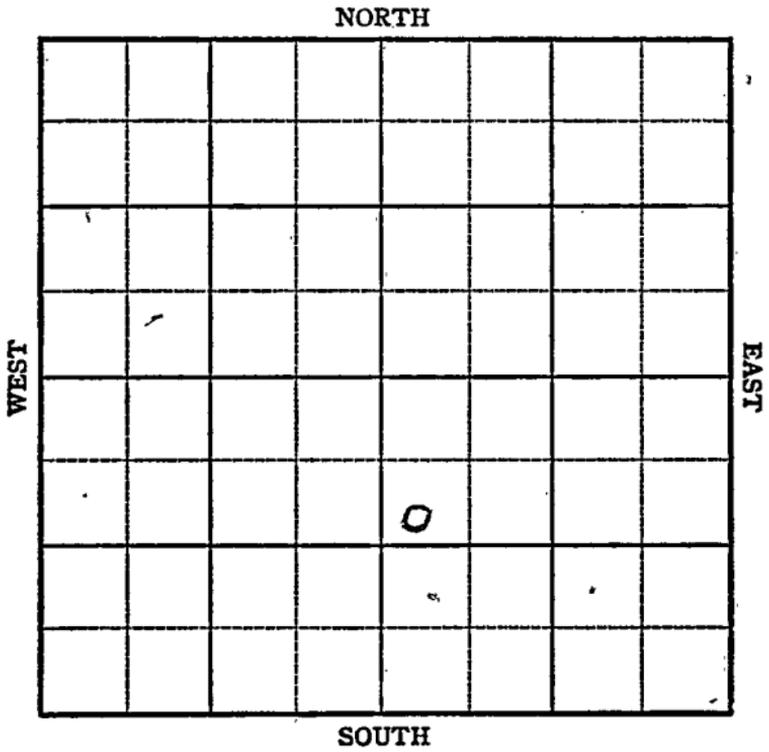

KANSAS

Rice

Sec. 12 Twp. 19 R. 10-W

Well No. #3 Flora Farm


Keyes Drlg Company
Silica Pool

990 Ft. from N. Line

_____ Ft. from S. Line

_____ Ft. from E. Line

330 Ft. from W. Line

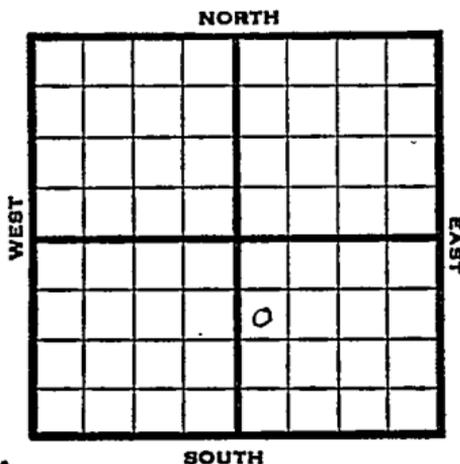

SW NW SE Elev. 1738'

REPORT

1947

3/12 8" @ 160
Drlg 1005'

3/18 Lans 2916
Cong 3244
Drlg 3250'

3/25 Arb 3244
5" @ 3245'
TD 3265
750' oil 12 wtr

4/2 " " "

4/9 Arb 3244
5" @ 3245
2000 Acid
Pump 524 Pot
Grav. 42
TD 3265

COMPLETED

Map No. 46 Sec. 12 Twp. 19 R. 10W

Well No. 3 Flora

Keyes Drlg Company

FIRST REPORT Contractor

SW NW SE

SECTION PLAT

990 Ft. from N. Line

_____ Ft. from S. Line

_____ Ft. from E. Line

330 Ft. from W. Line

Rice County

Location _____

Rig up _____

Drilling and Remarks:

8" @ .160

drlg. 1005

RECORD

Cased _____ in., _____ ft.

Sand _____

Gas _____

Oil _____

Total Depth _____

PRODUCTION

1st 24 hrs. Nat. _____

1st 24 hrs. after shot _____

Gas _____ Cu. Ft.

Dry Hole _____

Abandoned _____

Date

MAR 12 1947 19

S. J. LEWIS Scout

Misc. Small Maps	
Cards	<i>W.H.</i>
Tracing	<i>W.H.</i>
France Map	<i>W.H.</i>
Scarborough Map	<i>W.H.</i>
Pierce Map	<i>W.H.</i>
Geological Dept.	
Pierce Flat Book	

Map No. 146 Sec. 12 Twp. 19 R. 10WWell No. 3 FloraKeyes Drlg. Company**COMPLETE**

Contractor

SW NW SE

E 11938
SECTION PLAT990 Ft. from N. Line Ft. from S. Line Ft. from E. Line330 Ft. from W. Line

Rice County

Location _____

Rig up _____

Drilling and Remarks:

21 43244
5' @ 3245
2000 acid
Pump 524 1/2"

*42 2/4***RECORD**

Cased _____ in., _____ ft.

Sand _____

Gas _____

Oil _____

Total Depth 3265'**PRODUCTION**

1st 24 hrs. Nat. _____

1st 24 hrs. after shot _____

Gas _____ Cu. Ft.

Dry Hole _____

Abandoned _____

Date

APR 9 1947 19S. J. LEWIS Scout

Misc. Small Maps

Cards

Tracing

France Map

Scarborough Map

Pierce Map

Catalog Dept.

Index Book

Handwritten initials and scribbles over the list items.