


Section 12 Township 19 Range 10-W

Well No. #2, Flora

Company Keyes Drlg.

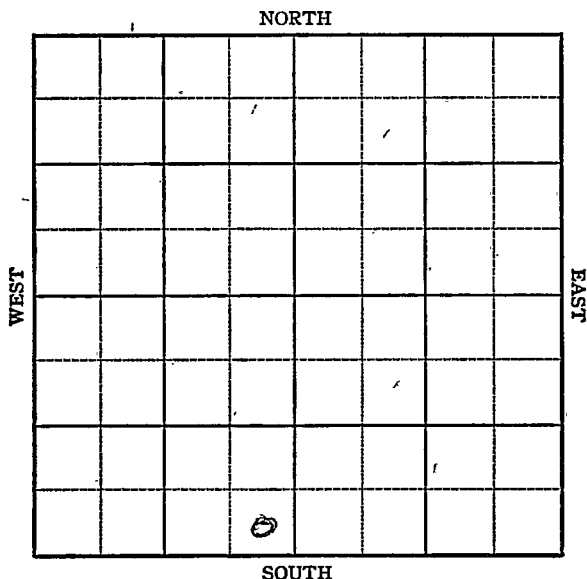

KANSAS

Rice County

Sec. 12 Twp. 19 R. 10W

Well No. 2 Flora Farm

Keyes Drlg.

Company


Silica Pool

Ft. from N. Line

330 Ft. from S. Line

330 Ft. from E. Line

Ft. from W. Line

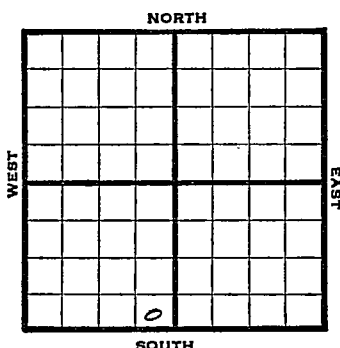

SE SW

1947

Elev. 1732

REPORT

1/2 8" @ 147'
Anhy 396'
Drlg 1925'

1/8 Lans 2910'
Arb 3262'
TD 3264-
5" @ 3263, RUST

1/15 " " "

1/21 TD 3266'
1500' oil


1/29 TD 3266'
Arb 3262
5" @ 3263
2000 Acid
Pump 360 Pot
42 Gravity

COMPLETED

Map No. 46 Sec. 12 Twp. 19 R. 10WWell No. 2 FloraKeyes Drlg. CompanyFIRST REPORT Contractor

SE SW

SECTION PLAT

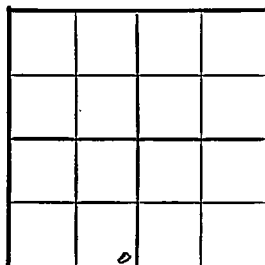 Ft. from N. Line330 Ft. from S. Line330 Ft. from E. Line Ft. from W. LineRice CountyLocation Rig up

Drilling and Remarks:

8" @ 147

Anhy 396

drlg. 1925

RECORD

Cased in., ft.Sand Gas Oil Total Depth

PRODUCTION

1st 24 hrs. Nat. 1st 24 hrs. after shot Gas Cu. Ft.Dry Hole Abandoned

Date

JAN 2 1947 19 S. J. LEWIS Scout

Misc. Small Maps

Cards

Tracing

France Map

Scarborough Map

Pierce Map

Dept.

Dist. Clerk

Map No. 46 Sec. 12 Twp. 19 R. 10W

Well No. 2 Flora

Keyes Drlg.

Company


COMPLETE

Contractor

SE SW

E 1, 1732.

SECTION PLAT

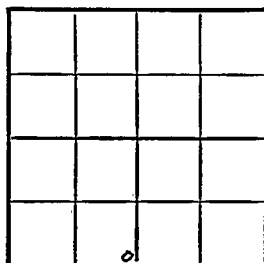

 Ft. from N. Line

330 Ft. from S. Line

330 Ft. from E. Line

 Ft. from W. Line

Rice County

Location

Rig up

Drilling and Remarks:

2283262
5' @ 3262
20000 acft
Pump 360 B

42 @ SW

RECORD

Cased in., ft.

Sand

Gas

Oil

Total Depth 3266

PRODUCTION

1st 24 hrs. Nat.

1st 24 hrs. after shot

Gas Cu. Ft.

Dry Hole

Abandoned

Date

JAN 29 1947 19

S. J. LEWIS

Scout

Misc. Small Maps	<i>[initials]</i>
Cards	<i>[initials]</i>
Tracing	<i>[initials]</i>
France Map	<i>[initials]</i>
Scarborough Map	<i>[initials]</i>
Pierce Map	<i>[initials]</i>
Geological Dept.	<i>[initials]</i>
Pierce Plat Book	<i>[initials]</i>