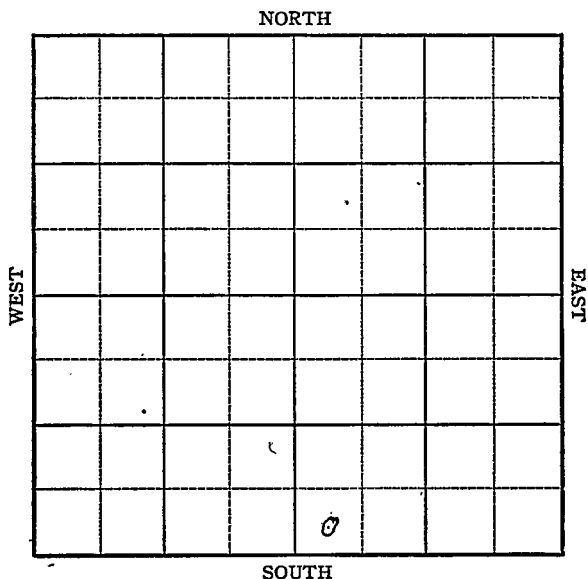


KANSAS

Rice county

Section 12 Township 19 Range 10-WWell No. #1, FloraCompany Keyes Drilling

KANSAS

Rice ✓

Sec. 12 Twp. 19 R. 10W

Well No. #1 Flora Farm

Keyes Drlg. Company

Silica


Ft. from N. Line

330 Ft. from S. Line

Ft. from E. Line

330 Ft. from W. Line

SW SE

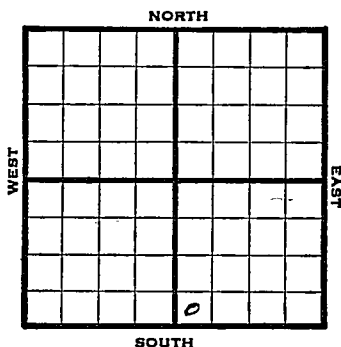

1946 Elev. 1740' REPORT

10/9	8" @ 121'
	Drlg 860'
10/15	Lans 2919
	Drlg 3200'
10/22	Arh 3256-62 TD
	5" @ 3259, RUST
10/29	" "
11/6	" "
11/12	" "
11/20	TD 3264'
	750' acid, swb 21 oil PH
11/27	Arb 3256'
	5" @ 3259'
	TD 3264'
	750 Acid
	Pump 742 POT
	42 Grav.

COMPLETED


KANSAS

Kansas Silica

Map No. 46 Sec. 12 Twp. 19 R. 10WWell No. 1 FloraKeyes Drlg. CompanyFIRST REPORT Contractor

SW SE

SECTION PLAT

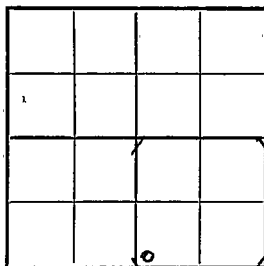 Ft. from N. Line330 Ft. from S. Line Ft. from E. Line330 Ft. from W. Line

Rice County

Location Rig up

Drilling and Remarks:

8" @ 121'

860'

RECORD

Cased in., ft.Sand Gas Oil Total Depth

PRODUCTION

1st 24 hrs. Nat. 1st 24 hrs. after shot Gas Cu. Ft.Dry Hole Abandoned

Date

OCT 9 1946 19 S. J. LEWIS Scout

Misc. Small Maps

Cards *Sarah*

Tracing *mf*

France Map *✓*

Scarborough Map

Pierce Map *mf*

Geological

Flora Plot Book

Map No. 46 Sec. 12 Twp. 19 R. 10W

Well No. 1 Flora

Keyes Drlg.

Company

COMPLETED

Contractor

SW SE

E11940
SECTION PLAT

Ft. from N. Line

330

Ft. from S. Line

Ft. from E. Line

330

Ft. from W. Line

Rice County

Location

Rig up

Drilling and Remarks:

Per 83256
5" @ 3259
750 acid
Run 742 R & D

42 0/8

RECORD

Cased _____ in., _____ ft.

Sand _____

Gas _____

Oil _____

Total Depth *3264*

PRODUCTION

1st 24 hrs. Nat. _____

1st 24 hrs. after shot _____

Gas _____ Cu. Ft.


Dry Hole _____

Abandoned _____

Date

NOV 27 1946 19

S. J. LEWIS Scout

 


Misc. Small Maps	
Geological Dept.	
Pierce Plate Book	