


KANSAS Rice

Section 12 Township 19 Range 10WWell No. 1 FloraCompany Holl & Branine

Chase

NORTH

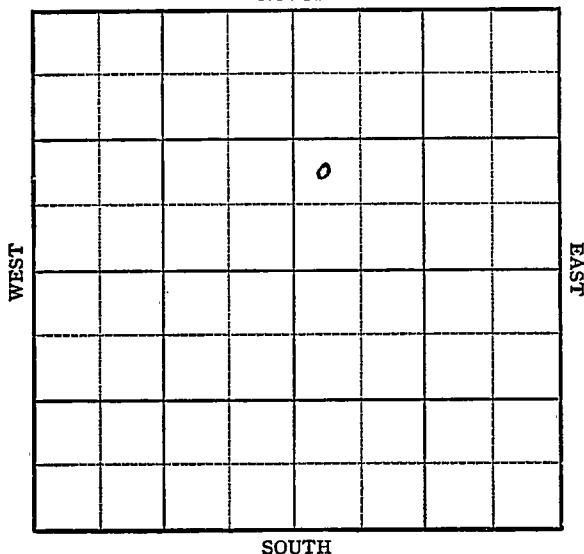

SOUTH

KANSAS

Rice

Sec. 12 Twp. 19 R. 10W ✓Well No. #1 Flora FarmHoll & Branine Company

Chase Pool


Ft. from N. Line

990' Ft. from S. Line

Ft. from E. Line

330' Ft. from W. Line

NW SW NE

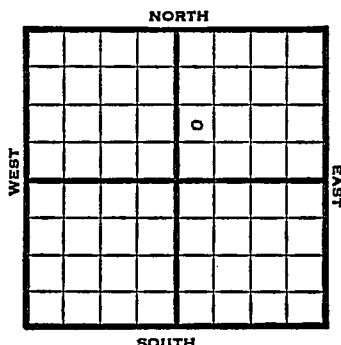

1949

lev 1722' REPORT

1/12 8" @ 216'
Lans 2907'
Cong. 3257'
TD 3261'
5" @ 3257
800' oil


1/19 "
1/26 "
2/2 "
2/9 "
2/16 45 shots 2991-98'
HFW squeeze
Drlg 3271'

2/23 "
3/2 "
3/9 TD 3271'
Cong 3257'
5" @ 3257'
Pump 35 oil Pot
42° Gr.
Comp

COMPLETED

Map No. _____ Sec. 12 Twp. 19 R. 10WWell No. 1 Flora_____
Holl & Branine Company**FIRST REPORT**_____
Contractor

NW SW NE

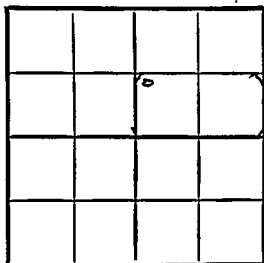SECTION PLAT_____
Ft. from N. Line990
Ft. from S. Line_____
Ft. from E. Line330
Ft. from W. LineRice County**RECORD**

Location _____

Cased _____ in., _____ ft.

Rig up _____

Sand _____

Drilling and Remarks:

Gas _____

Oil _____

Total Depth _____

8" @ 216Lans. 2907Cong. 3257TD 32615" @ 3257800' oil**PRODUCTION**1st 24 hrs. Nat.1st 24 hrs. after shot

Gas _____ Cu. Ft.

Dry Hole _____

Abandoned _____

Date

JAN 12 1949 19S. J. LEWIS Scout

Scout Cards
Land Small Map
Land Wall Map
Tracings
France Map
Pierce Map
Misc.

Kansas

Map No. 46 Sec. 12 Twp. 19 R. 10WWell No. 1 FloraHoll & Branine

Company

COMPLETE

Contractor

NW SW NE

E 1, 1922

SECTION PLAT

 Ft. from N. Line990 Ft. from S. Line Ft. from E. Line330 Ft. from W. Line

		6	

Rice County

Location Rig up

Drilling and Remarks:

Cong 32575" @ 3257Prod 35 oil Port42 2/3

RECORD

Cased in., ft.Sand Gas Oil Total Depth 3271

PRODUCTION

1st 24 hrs. Nat. 1st 24 hrs. after shot Gas Cu. Ft.Dry Hole Abandoned

Date

MAR 9 1949 19

S. J. LEWIS

Scout

11360

Scout-Cards
Land Small Map
Land Wall Map
Tracings
France Map
Pierce Map
Misc.

Edith