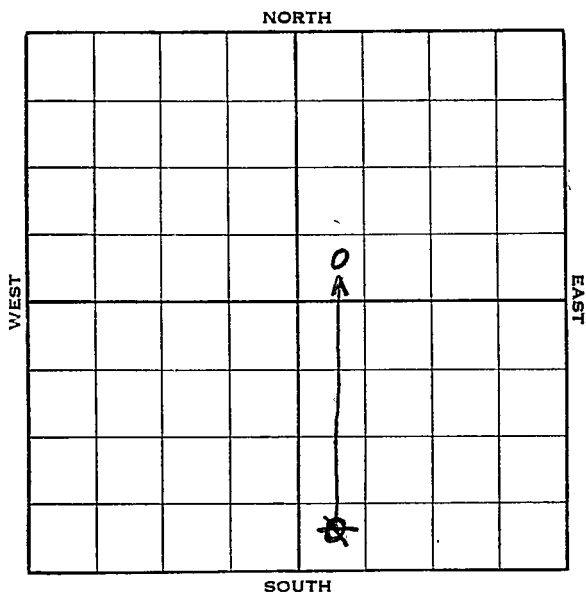


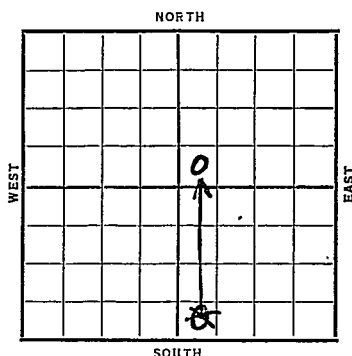
KANSAS

Rice

Section 12 Township 19 Range 10-WWell No. 1 FloraCompany Cities Service et al

KANSAS

Rice

Sec. 12 Twp. 19 R. 10-WWell No. #1 Flora FarmCities-Service et al Company Ft. from N. Line440 Ft. from S. Line Ft. from E. Line440 Ft. from W. Line

Date	REPORT
1938	
7/27	B.R.R.
8/5	8" - 259'. Dlg. 1540'.
8/12	Topeka 2510'. Lans. 2922'.
	Dlg. 2985'. No shows.
8/19	Cong. 3270'. Arb. 3300'.
	T. D. 3338'. Stains oil.
	Drill stem test showed 1470'
	water. S. D. 0.
8/26	5" - 3063'.
	Perf. 20 shots. 2997-3004'.
	1600' water 15 hrs.
8/31	5" - 3063'.
	Arb. 3300'.
	T. D. 3338'.
	ABANDONED

Rice

KANSAS

Map No. 46 Sec. 12 Twp. 19 R. 10WWell No. 1 Flora

Cities Service etal

Company

Community Deal

Contractor

FIRST REPORT
SW SE

SECTION PLAT

Special

 Ft. from N. Line440 Ft. from S. Line Ft. from E. Line440 Ft. from W. LineLocation Rig up

Drilling and Remarks:

BRR

RECORD

Cased in., ft.Sand Gas Oil Total Depth

PRODUCTION

1st 24 hrs. Nat. 1st 24 hrs. after shot Gas Cu. Ft.Dry Hole Abandoned

Date

JUL 27 1938 19

H. D. Hatfield Scout

Rice KANSAS

Map No. 46 Sec. 12 Twp. 19 R. 10WWell No. 1 FloraCities Service Oil et al Company

Contractor

ABANDONED

SW SE

 Ft. from N. Line440 Ft. from S. Line Ft. from E. Line440 Ft. from W. Line

SECTION PLAT

		0	

Location Rig up

Drilling and Remarks:

D & A

RECORD

Cased 5 in., 3063 ft.Sand Arb 3300Gas Oil Total Depth 3338

PRODUCTION

1st 24 hrs. Nat. 1st 24 hrs. after shot Gas Cu. Ft.Dry Hole Abandoned

Date

AUG 31 1938₁₉

H. D. Hatfield

Scout

Rice

KANSAS

Map No. 46 Sec. 12 Twp. 19 R. 10WWell No. 1 Flora

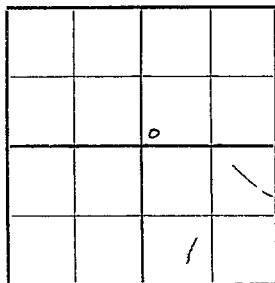
Cities Service Oil et al Company

CORRECTION

Contractor

SW NE

SECTION PLAT

 Ft. from N. Line440 Ft. from S. Line Ft. from E. Line440 Ft. from W. Line

BRANDENSTEIM POOL

Location Rig up Drilling and Remarks:
Reported SW SEThis well was
abandoned
Aug. 31, 1938*TD 3338*

RECORD

Cased in., ft.Sand Gas Oil Total Depth

PRODUCTION

1st 24 hrs. Nat. 1st 24 hrs. after shot Gas Cu. Ft.Dry Hole Abandoned

Date

JAN 21 1942 19

S. J. LEWIS Scout