


Section 22 Township 19 Range 10W

Well No. #4 Flora

Company Weaver

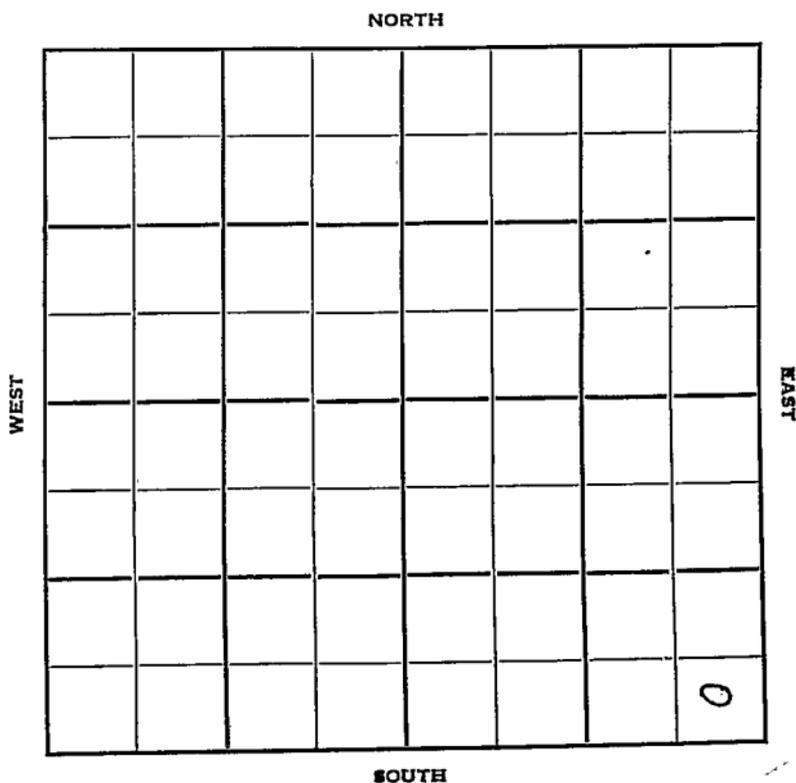

Rice

Sec. 12 Twp. 19 R. 10 W

Well No. #4 Flora Farm

Weaver Company

Gabbert & Jones Contractor


 Ft. from N. Line

330 Ft. from S. Line

330 Ft. from E. Line

 Ft. from W. Line

SE SE SE

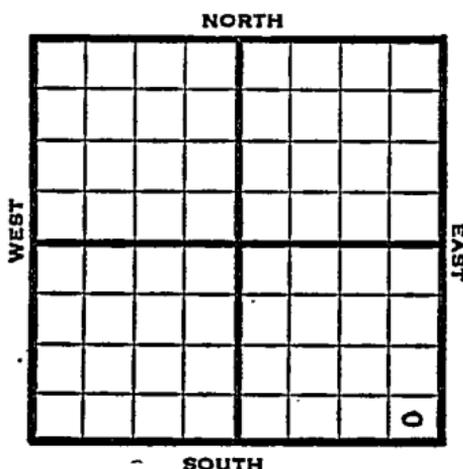

1952 Elev. 1734' REPORT

10/1 9-27-52
8" @ 190
Drlg. 1350

10/8 Br Li 2899' Lans. 2923
DST 3002-13 open 1 hr. rec. 40'
SOGCM Circ. @ 3120

10/15 Cong 3256 Arb 3273-75 TD
5" @ 3274'

10/22 NR

10/29 CO

11/5 DD 3280 NS
DD 3288 500A
B/5 galoph 500A S/10 galoph

11/12 Spud 9-27-52
D&A
TD 3288'
8" @ 190
Br. lime 2899', Lans 2923',
DST 3002-13, opn 1 hr., rec. 40'
so & gcm
Cong. 3256, Arb. 3273
TD 3275
5" @ 3274
DD 3280, DD 3288, 500A
B/5 goph 500A S/10 goph 1000 A
FU 500' sw 1 hr.
D&A

ABANDONED

| |
|---|
| County | Rice | State | Kansas | |
| Sec. | 12 (Blk. Twp.) | 19 (Sur. Rge.) | LOW Map No. | |
| Operator | Weaver | |
| Well No. | 4 | Farm | Flora | |
| Elev. | 1734 | Location | SE SE SE | |
| <table border="1"> <tr><td></td><td></td><td></td><td></td><td></td><td></td></tr> <tr><td></td><td></td><td></td><td></td><td></td><td>0</td></tr> </table> | |0 |
| |
| |
| |
| |
| |
| |
| |
| |
| |
| |
| | | | | | 0 | |
| 330 Ft. From | S Line | SE | |
| 330 Ft. From | E Line | Quarter | |
| Ist. Report | |
| Completion | NOV 12 1952 | |
| Remarks | Gabbert & Jones - Contr. | |
| Spudding Date | 9-27-52 | |

Drlg. Data D & A TD 3288
 8" @ 190 Br. lime 2899 Lans. 2923
 DST 3002-13 open 1 hr. Rec. 40' so & gcm
 Cong. 3256 Arb. 3273 TD 3275
 5" @ 3274 DD 3280 DD 3288 500 A
 B/ 5 goph 500 A S/ 10 goph 1000 A
 FU 500' sw 1 hr.

D & A

J. G. McGEHEE