

# KANSAS


Rice

Section 12 Township 19 Range 10W

Well No. 4 Gemeinhardt

Company Keyes Drlg.

Silica  
NORTH

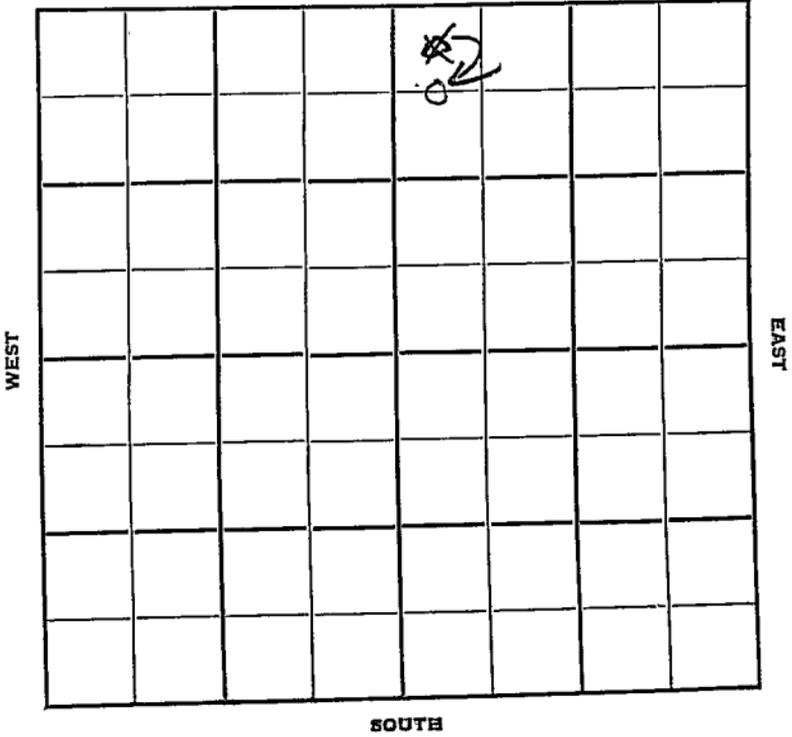

Sec. 12 Twp. 19 R. 10W

Well No. #4 Gemeinhardt Farm

Keyes Drig. Company

Silica Pool

660'

~~1055'~~ Ft. from N. Line

Ft. from S. Line

Ft. from E. Line


330'

~~395'~~

Ft. from W. Line

~~NW NE~~

~~CW & NW NE~~  
~~CW & NW NE~~

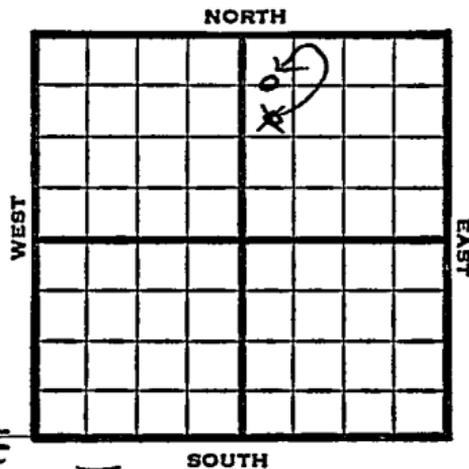

1949 <sup>u</sup> Elev 1724' REPORT

- 10/19 MIR
- 10/26 10" @ 160'  
Drig. 2780'
- 11/1 Lansing 2901'  
7" @ 2968'  
TD 2985'  
Swb 4 1/2 bbls oil PH
- 11/9 "
- 11/16 TD 2985'  
Lansing 2901'  
7" @ 2968'  
500 acid  
Pump 25 Oil Pot  
41° Gr.  
Comp

COMPLETED

Map No. \_\_\_\_\_ Sec. 12 Twp. 19 R. 10W

Well No. 4 Gemeinhardt

Keyes Drlg.

Company

**CORRECTION**

Contractor

C W L NW NE


**SECTION PLAT**

660 Ft. from N. Line

\_\_\_\_\_ Ft. from S. Line

\_\_\_\_\_ Ft. from E. Line

330 Ft. from W. Line

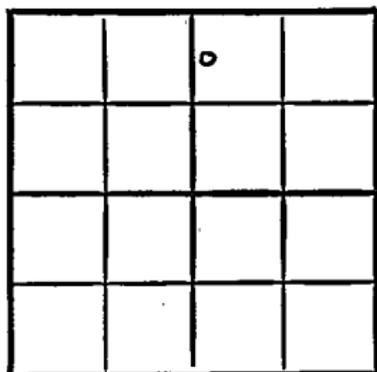

Rice County

**RECORD**

Location \_\_\_\_\_

Cased \_\_\_\_\_ in., \_\_\_\_\_ ft.

Rig up \_\_\_\_\_

Sand \_\_\_\_\_

Drilling and Remarks:

Gas \_\_\_\_\_

Oil \_\_\_\_\_

Reported

Total Depth \_\_\_\_\_

NW NE

**PRODUCTION**

1st 24 hrs. Nat. \_\_\_\_\_

1st 24 hrs. after shot \_\_\_\_\_

Gas \_\_\_\_\_ Cu. Ft.

Dry Hole \_\_\_\_\_

Abandoned \_\_\_\_\_

Date

OCT 26 1949

19

S. J. LEWIS

Scout

Map No. \_\_\_\_\_ Sec. 12 Twp. 19 R. 10W

Well No. 4 Gemeinhardt

Keyes Drlg. Company \_\_\_\_\_

Contractor \_\_\_\_\_

NW NE

FIRST REPORT  
SECTION PLAT

1055 Ft. from N. Line

\_\_\_\_\_ Ft. from S. Line

\_\_\_\_\_ Ft. from E. Line

395 Ft. from W. Line

		o	

Rice County

Location \_\_\_\_\_

Rig up \_\_\_\_\_

Drilling and Remarks:

M I R  
--

RECORD

Cased \_\_\_\_\_ in., \_\_\_\_\_ ft.

Sand \_\_\_\_\_

Gas \_\_\_\_\_

Oil \_\_\_\_\_

Total Depth \_\_\_\_\_

PRODUCTION

1st 24 hrs. Nat. \_\_\_\_\_

1st 24 hrs. after shot \_\_\_\_\_

Gas \_\_\_\_\_ Cu. Ft.

Dry Hole \_\_\_\_\_

Abandoned \_\_\_\_\_

Date

OCT 19 1949

19

S. J. LEWIS

Scout

Map No. \_\_\_\_\_ Sec. 12 Twp. 19 R. 10W

Well No. 4 Gemeinhardt

Keyes Drlg.

Company \_\_\_\_\_

**COMPLETE**

Contractor \_\_\_\_\_

C W L NW NE

*E. 1, 1924*

SECTION PLAT

660 Ft. from N. Line

\_\_\_\_\_ Ft. from S. Line

\_\_\_\_\_ Ft. from E. Line

330 *see correction*

~~395~~ Ft. from W. Line *verified*

*813*

		a	

Rice County

Location \_\_\_\_\_

Rig up \_\_\_\_\_

Drilling and Remarks:

*Loss 280'*

*7" C2965*

*500 acid*

*Plug 250' oil*

*412' L*

RECORD

Cased \_\_\_\_\_ in., \_\_\_\_\_ ft.

Sand \_\_\_\_\_

Gas \_\_\_\_\_

Oil \_\_\_\_\_

Total Depth 2985'

PRODUCTION

1st 24 hrs. Nat. \_\_\_\_\_

1st 24 hrs. after shot \_\_\_\_\_

Gas \_\_\_\_\_ Cu. Ft.

Dry Hole \_\_\_\_\_

Abandoned \_\_\_\_\_

Date

NOV 16 1949

19

S. J. LEWIS Scout