


Sec. 12 Twp. 19 R. 10-W

Well No. #1 Gemeinhardt Farm
Keyes Drlg. Company

330 Ft. from N. Line
 Ft. from S. Line
330 Ft. from E. Line
 Ft. from W. Line
NE/c

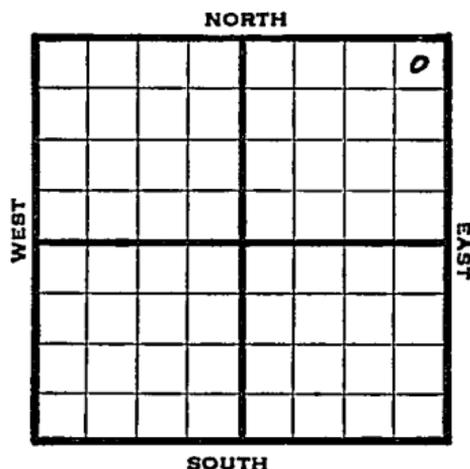

1947 Elev. 1719' REPORT

4/9 10" set 143'
Anhy. 370'
Drlg. 1707'

4/15 Lansing 2892'
TD 2960'
7" @ 2959'
RUST

4/23 TD 2978' 500 acid
Swb & Flow 20 bbls oil PH

4/29 " " "

5/7 " " "

5/13 " " "

5/20 " " "

5/27 TD 2978'

6/4 Lans. 2892'
7" @ 2959' 500 Acid
Pump 467 Oil and 30% w. Pot
42.0 Gr.
TD 2978'

COMPLETED

Map No. KAL Sec. 12 Twp. 19 R. 10W


Well No. 1 Gemeinhardt

Keyes Drlg. Company

FIRST REPORT Contractor

NE/C

SECTION PLAT

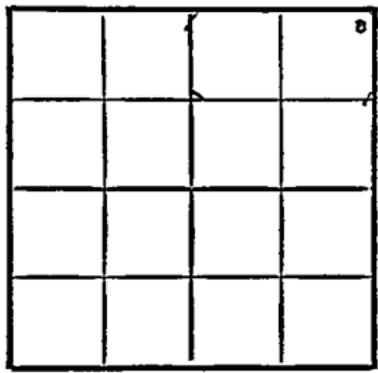

330 Ft. from N. Line

_____ Ft. from S. Line

330 Ft. from E. Line

_____ Ft. from W. Line

Rice County

RECORD

Location _____

Cased _____ in., _____ ft.

Rig up _____

Sand _____

Drilling and Remarks:

Gas _____

Oil _____

10" @ 143

Total Depth _____

anhy 370

drlg. 1707

PRODUCTION

1st 24 hrs. Nat. _____

1st 24 hrs. after shot _____

Gas _____ Cu. Ft.

Dry Hole _____

Abandoned _____

Date

APR 9 1947 19

S. J. LEWIS Scout

Map No. 46 Sec. 12 Twp. 19 R. 10W

Well No. 1 Gemeinhardt

Keyes Drlg. Company

COMPLETE Contractor

NE/C

E 1179
SECTION PLAT

330 Ft. from N. Line

_____ Ft. from S. Line

330 Ft. from E. Line

_____ Ft. from W. Line

			6

Rice County

RECORD

Location _____

Cased _____ in., _____ ft.

Rig up _____

Sand _____

Drilling and Remarks:

Gas _____

Lions 2892

Oil _____

7" @ 2909

Total Depth 2978

500 @ 2900

PRODUCTION

Prod. 467 oil +

1st 24 hrs. Nat. _____

1st 24 hrs. after shot _____

Gas _____ Cu. Ft.

Dry Hole _____

Abandoned _____

42 @ 2900

Date

S. J. LEWIS

JUN 4 1947 19

Scout