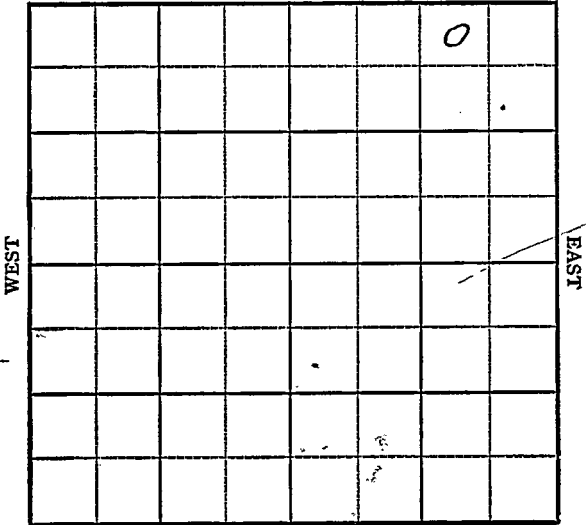


O. W. D. D

KANSAS

Rice

Section 12 Township 19 Range 10WWell No. 2 GemeinhardtIsorn Drlg.Company Keyes Drlg.Doran Pool
NORTH

SOUTH

KANSAS

Rice

O. W. D. D

Sec. 12 Twp. 19 R. 10W

Well No. #2 Gemeinhardt Farm

~~Isarn Drllg.~~
~~Keyes Drllg.~~

Company

Doran Pool


330' Ft. from N. Line

Ft. from S. Line

990' Ft. from E. Line

Ft. from W. Line

NW NE NE

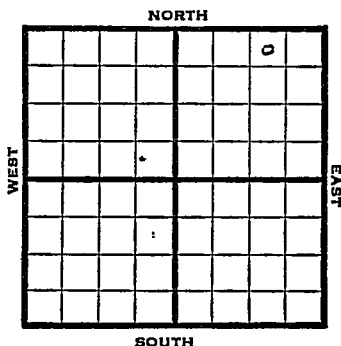

1948

Elev. 1717'

REPORT

9/15

10" @ 175'
Lans. 2891'
TD 2974'
7" @ 2971'

9/21

"

9/29

"

10/6

Lans 2891'
7" @ 2971'
Pump 75 oil & 5% W Pot.
Gr. 40°
TD 2974'

COMPLETED

1954

3/31

OTD 2974'
7" @ 2971'
DD 3100'
DST 3080-3100', opn 1 hr., rec. 480'
sw, 990#
Arb. 3256'
DST 3260-68', opn 1 hr., rec. ~~150X~~
105' hocm, 108' gas, 190#
TD 3268'

O. W. D. D

OVER

1954
4/21

Sil well TD 3100 OTD 2974
7" @ 2971 DD 3100'
DST 3080-3100' open 1 hr,
rec 480' SW 990# Arb. 3256'
DST 3260-68 open 1 hr rec 105' HOCM
108' gas, 190# TD 3268
CO to 3268 7 GOPH 500 A
B/11 BO 13 BW 7 hr.
Comp. 10 BOPD 30% wtr.

COMPLETED

Rice County Kansas State
 Map No. _____ Sec. 12 Twp. 19 R. 10W
 Well No. 2 Gemeinhardt
Keyes Drlg. _____ Company

FIRST REPORT

Contractor

NW NE NE

SECTION PLAT

330 Ft. from N. Line

_____ Ft. from S. Line

990 Ft. from E. Line

_____ Ft. from W. Line

Doran Pool

Remarks:


10" @ 176 Lans. 2891 TD 2974

7" @ 2971

Date
 SEP 15 1948

Scout
 S. J. LEWIS

SECTION 11A1

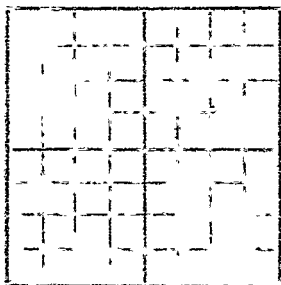



- Misc. Small Maps
- Cards
- Tracing
- France Map
- Scarborough Map
- Pierce Map
- Geological Dept.
- Pierce Plat Book

1. 1. 1. 1. 1.

Map No. 46 Sec. 12 Twp. 19 R. 10W

Well No. 2 Gemeinhardt

Keyes Drlg.

Company

COMPLETE

Contractor

NW NE NE

E1717
SECTION PLAT

330 Ft. from N. Line

Ft. from S. Line

990 Ft. from E. Line

Ft. from W. Line

Rice County

RECORD

Location

Cased in., ft.

Rig up

Sand

Drilling and Remarks:

Gas

Oil ☒

Total Depth 997 1/2

PRODUCTION

1st 24 hrs. Nat. "

1st 24 hrs. after shot

Gas Cu. Ft.

Dry Hole

Abandoned

Date

OCT 6 1948 19 S. J. LEWIS Scout

Line 2891
7" @ 297 1/2
Prod 75 oil 15 1/2 W
2x
40° SW













Misc. Small Maps

Cards

Tracing

France Map

Scarborough Map

Pierce Man

Geological Dept.

Pierre Plt Book



Dr. H. and Schaefer.

430

212

41

J. G. McGEHEE

Scout Cards	_____
Land Small Map	_____
Land Wall Map	_____
Tracings	_____
France Map	_____
Police Map	_____
Misc.	_____

APR 2 1954

Orig. Data

O. W. D. D.

County Rice State Kansas
 Sec. 12 (Blk. 19 (Sur. LOW Map No.
 (Twp.) (Rge.)
 Operator Isern Drlg.
 Well No. 2 Farm Gemeinhardt
 Elev. 1717 Location NW NE NE

330 Ft. From N Line NE
 990 Ft. From E Line Quarter

1st. Report

Completion APR 21 1954

Remarks

OWDD

Isern Drlg. - Contr.

Spudding Date

Drlg. Data Oil well TD 3100OTD 2974 7" @ 2971 DD 3100 DST 3080-3100 open 1 hr. Rec. 480' sw 990#Arb. 3256 DST 3260-68 open 1 hr.Rec. 105' hocm 108' gas 190# TD 3268CO to 3268 7 goph 500 A B/ 11 bo13 bw 7 hr. Comp. 10 bopd 30% wtr.

J. G. McGENEE

25A

Scout Cards	mm
Land Small Map	
Land Wall Map	
Tracings	
France Map	
Piece Map	
Misc.	

APR 27 1954

Orig. - Date