


Map No. KANSAS Sec. 12 Twp. 19 R. 2^W
 Well No. 1- Wallace Farm
M^c Pherson Oil Company

NORTH

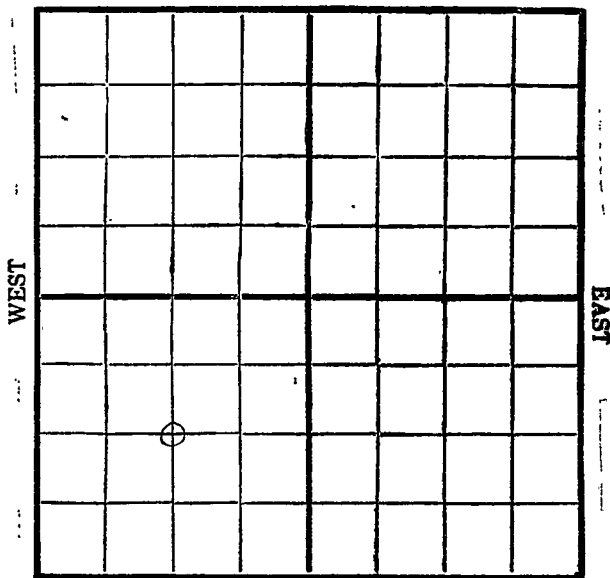

SOUTH

Location _____

Drilling Remarks _____

Rig Up _____

Drilling Remarks _____

RECORD

Cased _____ in. _____ ft.

Sand _____

Gas _____

Oil _____

Total Depth _____

PRODUCTION

1st 24 hrs. Nat. _____

1st 24 hrs. after shot _____


Gas _____ cu. ft.

Dry Hole _____

Abandoned _____

Map No. KANSAS Sec. 12 Twp. 19 R. 2^w
Well No. 1 Wallace Farm
M^cPherson Oil & Gas Company

NORTH

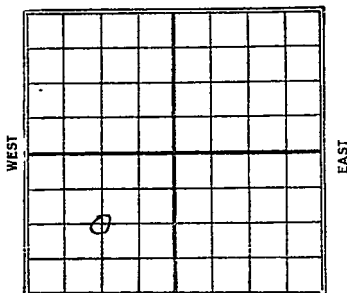

Ft. from N. Line

1320 Ft. from S. Line

Ft. from E. Line

1320 Ft. from W. Line

SOUTH

1929

Date

REPORT

10/23	Big
10/30	Up
11/6	S.D. 150'
11/13	cem 20"-150'
11/20	S.D. 1450'
11/27	10ly 1790
12/14	0 21.40
12/11	2320-4K. 10"
12/18	Wrlg 2505'
12/23	Report
12/30	Wrlg 12865'
1930	
1/8	Phat 2914-15' Cem 8"
1/15	show gas 2915
1	P.B.P.
1/22	sand 2915-43'
	T.D. 2943
	8 1/2 M gas
	950# P.B.P.
	Pomp.

M. C. Pherson
 Map No. **KANSAS** Sec. 12 Twp. 19 R. 2 W
43
 Well No. 1 Wallace

M. C. Pherson O & G Company

Contractor


SECTION PLAT

_____ Ft. from N. Line

1320 Ft. from S. Line

_____ Ft. from E. Line

1320 Ft. from W Line

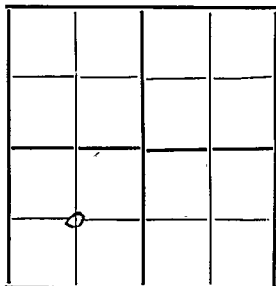

FIRST REPORTS

Location _____

Rig up _____

Drilling and Remarks:

Rig

RECORD

Cased _____ in., _____ ft.

Sand _____

Gas _____

Oil _____

Total Depth _____

PRODUCTION

1st 24 hrs. Nat. _____

1st 24 hrs. after shot _____

Gas _____ Cu. Ft.

Dry Hole _____

Abandoned _____

Date

OCT 23 1929

192

S. J. LEWIS

Scout

43 *McPherson*
 Map No. **KANSAS** Sec. 12 Twp. 19 R. 2W

Well No. 1 Wallace

McPherson Oil & Gas Company

Contractor

SECTION PLAT

_____ Ft. from N. Line

1320 Ft. from S. Line

_____ Ft. from E. Line

1320 Ft. from W. Line

COMPLETED

Location _____

Rig up _____

Drilling and Remarks:

8 1/2 M Gas

950 # Rock Pr

RECORD

Cased _____ in., _____ ft.

Sand 2915 - 2943

Gas _____

Oil _____

Total Depth 2943

PRODUCTION

1st 24 hrs. Nat. _____

1st 24 hrs. after shot _____

Gas _____ Cu. Ft.

Dry Hole _____

Abandoned _____

Date

JAN 22 1930

S. J. LEWIS Scout