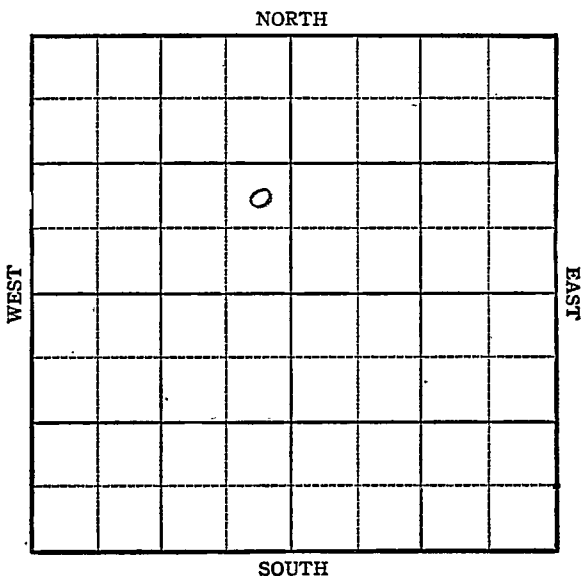


KANSAS Barton County

Section 12 Township 19 Range 11WWell No. #1 RaderCompany Cities Service Oil

KANSAS

Barton

Sec. 12 Twp. 19 R. 11W

Well No. #1 Rader Farm

Cities Service Oil Company


Kraber

 Ft. from N. Line

990 Ft. from S. Line

330 Ft. from E. Line

 Ft. from W. Line

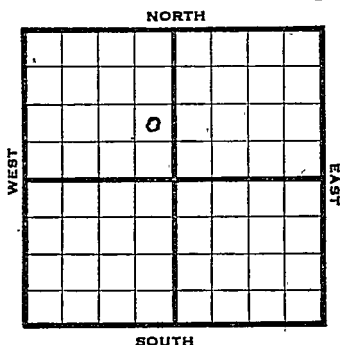

NE SE NW

1944

R E P O R T

9/20 Location

9/28 "

10/4 "

10/11 "

10/18 Aband. Loc.

ABANDONED

KANSAS

Pool Name KraherMap No. 46 Sec. 12 Twp. 19 R. 11WWell No. 1 RaderCities Service Oil

Company

FIRST REPORT

Contractor

NE SE NW

SECTION PLAT

		o	

 Ft. from N. Line990 Ft. from S. Line330 Ft. from E. Line Ft. from W. LineBarton CountyLocation XRig up

Drilling and Remarks:

RECORD

Cased in., ft.Sand Gas Oil Total Depth

PRODUCTION

1st 24 hrs. Nat. 1st 24 hrs. after shot Gas Cu. Ft.Dry Hole Abandoned

Date

SEP 20 1944 19S. J. LEWIS Scout

Pool Name KraberMap No. 46 Sec. 12 Twp. 19 R. 11WWell No. 4 RaderCities Service

Company

CORRECTION

Contractor

NE SE NW

SECTION PLAT

	o		

 Ft. from N. Line990 Ft. from S. Line330 Ft. from E. Line Ft. from W. LineBarton County

RECORD

Location Cased in., ft.Rig up Sand

Drilling and Remarks:

Gas Oil

Reported As

Total Depth

#1 Rader

PRODUCTION

1st 24 hrs. Nat. 1st 24 hrs. after shot Gas Cu. Ft.Dry Hole Abandoned

Date

SEP 27 1944 19

S. J. LEVINS

Scout

KANSAS

Pool Name KraberMap No. 46 Sec. 12 Twp. 19 R. 11WWell No. 4 RaderCities Service Oil

Company

ABANDONED

Contractor

NE SE NW

SECTION PLAT

		o	

Ft. from N. Line

990

Ft. from S. Line

330

Ft. from E. Line

Ft. from W. Line

BartonLocation ✓

Rig up

Drilling and Remarks:

RECORD

Cased in., ft.Sand Gas Oil Total Depth

PRODUCTION

1st 24 hrs. Nat. 1st 24 hrs. after shot Gas Cu. Ft.Dry Hole Abandoned

Date

OCT 18 1944 19S. J. LEWIS

Scout