

Barton

KANSAS

Section 12 Township 19 Range 13WWell No. #1 KrentzelCompany Westgate-Greenland

NORTH

0							

WEST

EAST

SOUTH

Barton KANSAS

Sec. 12 Twp. 19 R. 13W

Well No. #1 Krentzel Farm

Westgate-Greenland Company

Jackson Drlg. - Contr. Contractor

Wildcat


330' Ft. from N. Line

Ft. from S. Line

Ft. from E. Line

330' Ft. from W. Line

NW NW NW

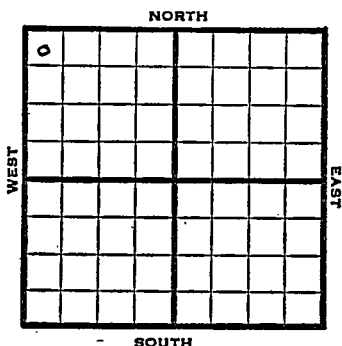

1950 Elev. 1837 REPORT

11/22 Spud 11-18-50
8-5/8" @ 237'

12/6 Drlg. 1635'
Spud 11-18-50
D&A TD 3453

8-5/8" @ 237' Anhy 990'

Lans. 3138'

DST 3138-83 Rec. mud Heab. 3007'

Br. lime 3122 Lans. 3140

Cong. 3370 Ch Cong. 3385

Arb. 3416' TD 3453

D&A ABANDONED

County Barton State Kansas
 Sec. 12 (Blk. 19 (Sur. 13W Map No.
 (Twp. 19 (Rge. 13W
 Operator Westgate-Greenland
 Well No. 1 Farm Krentzel
 Elev. _____ Location NW NW NW

0						

FIRST REPORT

330 Ft. From N Line NW
330 Ft. From W Line Quarter
 Ist. Report NOV 22 1950
 Completion _____
 Remarks _____
Jackson Drlg. - Contr.
 Spudding Date 11-18-50

Drlg. Data Wildcat
8 5/8" @ 237 drlg. 1635

County Barton State Kansas
 Sec. 12 (Blk.
Twp.) 19 (Sur.
Rge.) 13W Map No.
 Operator Westgate-Greenland
 Well No. 1 Farm Krentzel
 Elev. 1837 Location NW NW NW

0					

330 Ft. From N Line NW
330 Ft. From W Line Quarter

1st. Report

Completion DEC 6 1950

Remarks Wildcat

Jackson Drlg. - Contr.

Spudding Date 11-18-50

Drlg. Data D & A TD 3453

8 5/8" @ 237 Anhy 990 Lans. 3138

DST 3138-83 Rec. mud Heeb. 3007

Br. lime 3122 Lans. 3140 Cong. 3370

Ch. Cong. 3385 Arb. 3416 TD 3453

D & A

J. E. TYRA